

MISSISSIPPI DEPARTMENT OF NATURAL RESOURCES

Bureau of Land and Water Resources

Southport Mall

P.O. Box 10631

Jackson, Mississippi 39209

WATER WELL DRILLERS LOG

CODED

Smart
D029
1-19-86

~~1/19/86 to 19~~ 19 86 Tom Griffith Water Well Ser Smith
date well completed firm name county well located

LANDOWNER: <u>Shell Oil</u> <u>P.O. Box 61001</u> <u>New Orleans, LA 70160</u> (mailing address)	description of formations encountered	from	to
WELL LOCATION: sec. <u>9</u> T. <u>1</u> (N) R. <u>9</u> (E) <u>7</u> miles <u>SW</u> of <u>Taylorville</u> (distance) (direction) (nearest town)	Sandy Clay	0	10
WELL PURPOSE: <u>oil log</u> (home, irrigation, municipal, industrial)	Rock	10	12
WELL COMPLETION DATA: (1) diameter (inches) <u>3"</u>	Clay	12	15
(2) total depth (feet) <u>840'</u>	Rock	15	19
(3) static water level (feet) <u>160'</u> (below) above top of ground. <u>steel</u>	Clay	19	35
(4) casing <u>3" PVC</u> <u>800'</u> (material) (depth)	Rock	35	37
<u>NA</u> if telescope see back. (size)	Clay	37	55
(5) screen <u>40'</u> <u>800'</u> (length) (depth to top)	Sand	55	140
<u>3"</u> <u>slotted pipe</u> (size) (material)	Clay	140	320
(6) pump <u>air</u> <u>70</u> (HP) (yield gpm)	Clay w/ streaks of sand	320	580
<u>diesel</u> (type power)	limestone + shells	580	760
(7) electric log <u>no</u> (yes or no)	Sand	760	840
<u>n/a</u> (organization running log)			
(8) how well bottom plugged <u>BCW</u>			

RECEIVED


MAR 17 1986

Department of Natural Resources
Bureau of Land & Water Resources

DRILLERS REMARKS:

If well telescopes please sketch and show depths.

GROUND LEVEL

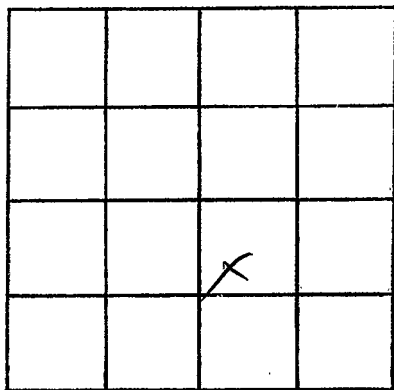

SECTION 9

Please indicate well location X.

ADDITIONAL INFORMATION

If more than one screen,
show locations of each on sketch.