

MISSISSIPPI DEPARTMENT OF NATURAL RESOURCES

Bureau of Land and Water Resources

Southport Mall

P.O. Box 10631

Jackson, Mississippi 39209 **CODED**

WATER WELL DRILLERS LOG

TOM GRIFFITH

PLUMBING & WELL SERVICE, INC. *Smith*

July 1 1983
date well completed

320 MAYSON AVE.
COLUMBIA, MS 39429

county well located

LANDOWNER: David New Drilling

P.O. Box 1487

Natchez, MS 39120
(mailing address)

WELL LOCATION:

sec. 14 T. 10 (N) R. 15 (E)
3 miles W of Taylorville
(distance) (direction) (nearest town)

WELL PURPOSE: oil location
(home, irrigation, municipal, industrial)

WELL COMPLETION DATA:

- (1) diameter (inches) 3"
- (2) total depth (feet) 300'
- (3) static water level (feet) 60' below top of ground.
- (4) casing steel, 260',
(material) (depth)
N/A (size) if telescope see back.
- (5) screen 40', 260'
(length) (depth to top)
3", slots
(size) (material)
- (6) pump air lift 65
(HP) (yield gpm)
air
(type power)
- (7) electric log none
(yes or no)

(organization running log)
- (8) how well bottom plugged welded

description of formations encountered	from	to
Chalk	0	40
Sand	40	100
Chalk	100	240
Sand	240	300

CODED

DEPT. OF NATURAL RESOURCES
BUREAU OF LAND & WATER RESOURCES


JUL 25 1983

RECEIVED

DRILLERS REMARKS:

If well telescopes please sketch and show depths.

GROUND LEVEL

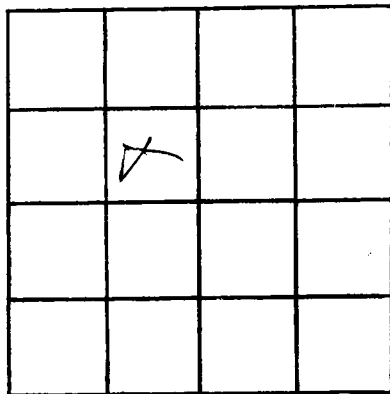

SECTION 14

Please indicate well location X.

ADDITIONAL INFORMATION

If more than one screen,
show locations of each on sketch.