

MISSISSIPPI DEPARTMENT OF ENVIRONMENTAL QUALITY
Office of Land and Water Resources

P. O. Box 10631
 Jackson, MS 39289-0631
WATER WELL DRILLERS LOG

COUNTY WELL LOCATED SMITH	
WELL NUMBER Q-37	CODED
2-26-02	
DATE WELL COMPLETED	

PERMIT NUMBER
NAME OF DRILLING FIRM PARKER WELL SERVICE

NAME & MAILING ADDRESS OF LANDOWNER JUDY KEYS			
RT. 3			
TAYLORSVILLE MS			
WELL LOCATION	SEC	TOWNSHIP	RANGE
	21	T1	R14
DISTANCE	DIRECTION	NEAREST TOWN	
15 Miles	NORTH of	T. J. VILLE	
OTHER LANDMARK ROY STRINGER STORE			
WELL PURPOSE Home, Irrigation, Municipal, Industrial, Fish Pond, etc. HOME			

PUMP DATA		
PUMP TYPE (Circle One): Submersible, Turbine, <input checked="" type="radio"/> Jet, Flowing Well, Other (Describe) _____		
POWER TYPE (Circle One): <input checked="" type="radio"/> Electric, Tractor, Diesel, Gasoline, <input checked="" type="radio"/> Butane, Other (Describe) _____		
Pump Capacity (GPM) 10	No. of Stages 3	Setting Depth 160 FT.
PUMP TEST		
Well yielded 6 GPM with a drawdown of 15 ft. after _____ hours of pumping		

WELL DATA		
Well Depth (ft.) 180	Casing Diameter (In.) 2"	Casing Length (Ft.) 170'
Type of Casing PVC	Hole Depth 190	Depth to Static Water Level 140'
TYPE OF COMPLETION: (Circle One or More): <input checked="" type="checkbox"/> Gravel Packed, <input checked="" type="checkbox"/> Underreamed, <input type="checkbox"/> Telescoped, <input checked="" type="checkbox"/> Natural Development, <input type="checkbox"/> Open Hole, <input type="checkbox"/> Other (Describe) _____		

LOG DATA	
TYPE OF LOG RUN (Circle One): No Log Run, Electric, <input checked="" type="checkbox"/> Gamma Ray, <input checked="" type="checkbox"/> Density, <input type="checkbox"/> Sonic, <input type="checkbox"/> Neutron, Other (Describe) _____	
Name of Organization Running Log STATC	

WELL GROUTED TO A DEPTH OF 4 FEET
 Type Grout (circle one): Cement, Bentonite, or Mix

GEOLOGIC DATA (Office Use Only)			
Surface Elev.	Geologic Unit	Unit Thickness	Depth to Top
Subs. SWL	Date	Analysis	Aquifer Test

SCREEN DATA		
Diameter - Inches 2"	Length - Feet 10'	Slot Size - Inches .08
Screen Type PVC	Depth to Bottom - Feet 180'	


Driller's Remarks SAND TO 90' COARSE DRILL CLAY & ROCK OVER
Top of Lap Pipe or Reduction in Casing
FEET
IF TELESCOPED OR MORE THAN ONE SCREEN: USE BACK PAGE

DESCRIPTION OF FORMATIONS ENCOUNTERED	FROM	TO
SAND	0	90
SAND	90	130
CLAY	130	160
SAND	160	180

FORMATIONS (Continued)	FROM	TO
RECEIVED		
MAR 2001		
BY: OLWR		

If well telescopes please sketch and show depths.

GROUND LEVEL

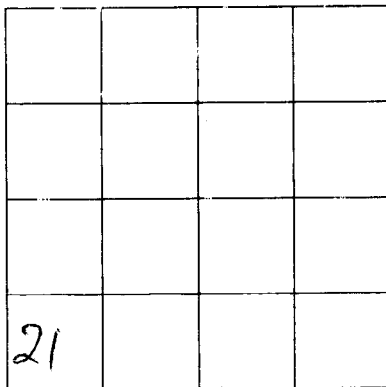

R/H W
SECTION 21

Please indicate well location X.

ADDITIONAL INFORMATION

AND SAND TO 130
130 TO 160 CLAY
160 TO 180 SAND

If more than one screen,
show location of each on sketch.