

MISSISSIPPI DEPARTMENT OF NATURAL RESOURCES

Bureau of Land and Water Resources

Southport Mall

P.O. Box 10631

Jackson, Mississippi 39209

WATER WELL DRILLERS LOG

SMITH
O 2000

date well completed 19 84 Roy K. West Drlg firm name Smith county well located

LANDOWNER:
CLEO SHELBY
Taylorville MS
(mailing address)

description of formations encountered	from	to
<u>CLAY</u>	<u>0</u>	<u>32</u>
<u>SAND</u>	<u>32</u>	<u>90</u>

WELL LOCATION:
sec. 19 T 1 N R 9 E
9 miles N of Taylorville
(distance) (direction) (nearest town)

WELL PURPOSE:
(home, irrigation, municipal, industrial)

WELL COMPLETION DATA:

- (1) diameter (inches) 2"
 - (2) total depth (feet) 90'
 - (3) static water level (feet) 36' below above top of ground.
 - (4) casing PVC, 85',
(material) (depth)
 if telescope see back.
(size)
 - (5) screen 5' 85'
(length) (depth to top)
2", PVC
(size) (material)
 - (6) pump 1 12
(HP) (yield gpm)
REH
(type power)
 - (7) electric log no
(yes or no)
- (organization running log)
- (8) how well bottom plugged WASH VALVE

DRILLERS REMARKS:


DEPT. OF NATURAL RESOURCES
BUREAU OF LAND & WATER RESOURCES

DEC - 3 1984

RECEIVED

If well telescopes please sketch and show depths.

GROUND LEVEL

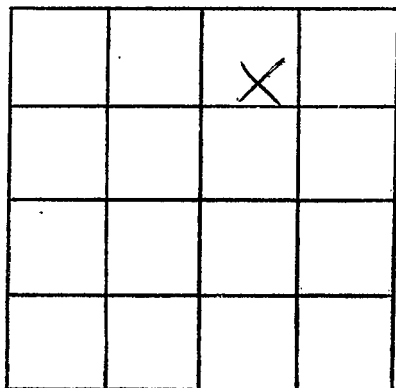

SECTION 19

Please indicate well location X.

ADDITIONAL INFORMATION

If more than one screen,
show locations of each on sketch.