

SMITH

6 P 8-6-60

WATER WELL DRILLERS LOG

? 0

Date: Aug 6, 1960, Driller: James A White County Smith
(Name)

(1) Owner of Land:	Description & Color of Materials Sand, Clay, Red Clay, Shell, etc.	Thick- ness Feet	Depth Feet
(Name) <u>Bernice Sellers</u>	<u>Red Silts</u>	4	
(Address) <u>Magee 131</u>	<u>White Chalk</u>	70	
(2) Location: $\frac{1}{4}$, $\frac{1}{4}$, Sec. <u>4</u> T. <u>R.</u> <u>10N 16W</u>	<u>Blue Shale</u>	130	
$\frac{1}{2}$ miles <u>East</u> , of <u>Magee</u> (distance) (direction) (Nearest Town) <u>Shady Grove</u>	<u>Sand</u>	150	200
(3) Topography: <input checked="checked" type="checkbox"/> (Hilly) <input type="checkbox"/> (Flat) <input type="checkbox"/> (Level)			
(4) Purpose of Well: <u>Domestic</u> (Domestic Irrigation Municipal, Industrial, Other)			


Information upon completion of well:

- (1) Diameter 2 inches.
(2) Total Depth 200 feet.
(3) Water Level Flowing feet below top of ground.
(4) Cased to 150, Size 2.
(5) Screen: Size None Length .
(6) Were any formations sealed against pollution?
 yes, no.

If YES depth of formation

Why cut out top water

Drillers Remarks:

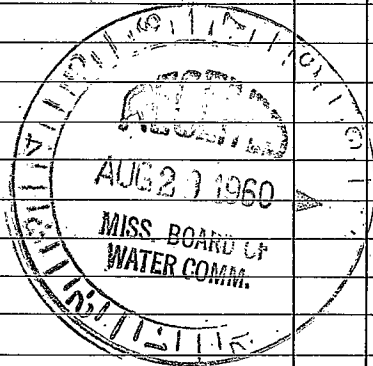

(Use Back Side)

Well No.

