

SMITH

MISSISSIPPI BOARD OF WATER COMMISSIONERS

P 1

8-5-62

WATER WELL DRILLERS LOG

Date: 8/5, 1962, Driller: Wayne White, County Smith

(1) Owner of Land: A G Cannon (Name)
mrs Cannon (Address)
(2) Location: 1/4, 1/4, Sec. 10 T10R16, 4 miles W of Mrs (distance, direction, Nearest Town)
(3) Topography: X (Hilly, Flat, Level)
(4) Purpose of Well: Domestic (Domestic Irrigation, Municipal, Industrial, Other)


Table with 3 columns: Description & Color of Materials (Sand, Clay, Red Clay, Shell, etc.), Thickness Feet, Depth Feet. Contains handwritten entries: Red Clay (16), White Chalk (6), Sand (16) with total depth 32.

Information upon completion of well:

(1) Diameter 2 inches.
(2) Total Depth 32 feet.
(3) Water Level 16 feet below top of ground.
(4) Cased to, Size
(5) Screen: Size 1/4, Length 6 ft
(6) Were any formations sealed against pollution?
yes, no.

if YES depth of formation
Why

Drillers Remarks:

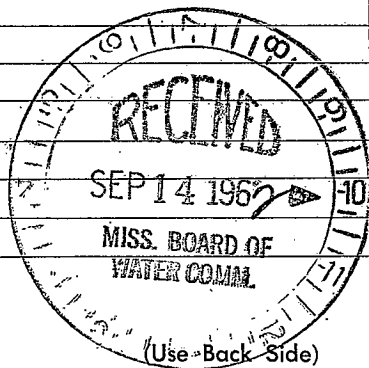

Well No.

[The page contains extremely faint and illegible text, likely bleed-through from the reverse side of the document. No specific words or phrases can be discerned.]