

76
SMITH
P 2
3/3 2-6-61

MISSISSIPPI BOARD OF WATER COMMISSIONERS 0

WATER WELL DRILLERS LOG P

Date: 2/6, 19 61, Driller: Wagnor Reebert County Smith
(Name)

(1) Owner of Land: Frank Reebert
(Name)
Rt 4 Mitaline
(Address)

(2) Location: NW 1/4, SE 1/4, Sec. 6 T10R6E2
5 miles E, of Magnolia
(distance) (direction) (Nearest Town)

(3) Topography: X
(Hilly) (Flat) (Level)

(4) Purpose of Well: Domestic
(Domestic Irrigation, Municipal, Industrial, Other)

Description & Color of Materials Sand, Clay, Red Clay, Shell, etc.	Thick- ness Feet	Depth Feet
<u>Red Clay</u>	<u>20</u>	<u>20</u>
<u>Sand</u>	<u>53</u>	<u>75</u>
<u>white Chalk</u>	<u>72</u>	<u>147</u>
<u>white sand</u>	<u>7</u>	<u>154</u>

Information upon completion of well:

(1) Diameter 2 inches.

(2) Total Depth 154 feet.

(3) Water Level 130 feet below top of ground.


(4) Cased to 149, Size 2"

(5) Screen: Size 1/4, Length 5 ft.

(6) Were any formations sealed against pollution?
_____ yes, _____ no.

If YES depth of formation _____
Why rod Pump
Drillers Remarks: 3/4 hr

137.2
138.8
139.8
PX 2
1st depth
Sp Cond 70

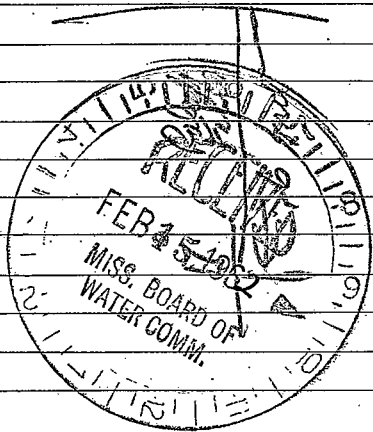

(Use Back Side)

Well No.

