

PJ
8-1-60

WATER WELL DRILLERS LOG

? 6

Date: Aug 1, 1960, Driller: James A. White County Smith
(Name)

(1) Owner of Land: Hulon Windsor
(Name)
Miss Miss
(Address)

(2) Location: 10N 16W Sec 1 T. R
0.5 miles at Miss of
(distance) (direction) (Nearest Town)

(3) Topography: Edge of Hill
(Hilly) (Flat) (Level)

(4) Purpose of Well: Domestic Use
(Domestic Irrigation
Municipal, Industrial, Other)

Description & Color of Materials Sand, Clay, Red Clay, Shell, etc.	Thick- ness Feet	Depth Feet
<u>Red clay</u>	<u>10</u>	
<u>Shale</u>	<u>20</u>	
<u>Blue shale</u>	<u>100</u>	
<u>Sand</u>	<u>10</u>	<u>200</u>

Information upon completion of well:

(1) Diameter 2 inches.

(2) Total Depth 200 feet.

(3) Water Level 50 feet below top of ground.


(4) Cased to 138, Size 2.

(5) Screen: Size none Length _____.

(6) Were any formations sealed against pollution?
X yes, _____ no.

If YES depth of formation _____
Why put out for water

Drillers Remarks: _____

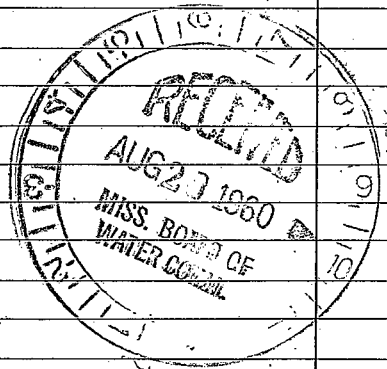

(Use Back Side)

Well No.

