


If well telescopes please sketch and show depths.

GROUND LEVEL

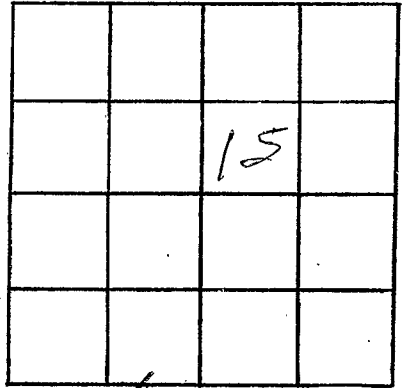

R16W

SECTION 15

Please indicate well location X.

ADDITIONAL INFORMATION

part house well
to Barnett Red
meze

If more than one screen,
show locations of each on sketch.