

CODED T M M Z

MISSISSIPPI
BOARD OF WATER COMMISSIONERS
416 North State Street
Jackson, Mississippi 39201

MAR 16 1972

SMITH
P 10
1-18-72

WATER WELL DRILLERS LOG

1-18 date well completed 172 W. K. Barnes Water Wells Smith firm name county well located

LANDOWNER: Donald Pittman
Rt. 1
Unige miss
(mailing address)

WELL LOCATION:
sec. 26 T 10 N R. 16 E
7 miles S-E of Unige
(distance) (direction) (nearest town)

WELL PURPOSE: HOME
(home, irrigation, municipal, industrial)

- WELL COMPLETION DATA:
- (1) diameter (inches) 2
 - (2) total depth (feet) 202
 - (3) static water level (feet) 120 below top of ground.
 - (4) casing Galv., 198
(material) (depth)
2" if telescope see back.
(size)
 - (5) screen 4'
(length) (depth to top)
06, Stainless S
(size) (material)
 - (6) pump 1 1/2 6
(HP) (yield gpm)
elec.
(type power)
 - (7) electric log no
(yes or no)
 - (organization running log)
 - (8) how well bottom plugged Washed


description of formations encountered	from	to
Red Clay	0	15
Red Sand	15	26
Course White Sand	26	52
yellow Clay	52	86
Sand Rock	86	87
yellow Clay	87	120
Blue Clay	120	146
Rock	146	148
Blue Clay	148	161
Fine Blue Sand	161	165
Blue Clay	165	180
Blue Sand	180	202

CODED

DRILLERS REMARKS:

If well telescopes please sketch and show depths.

GROUND LEVEL

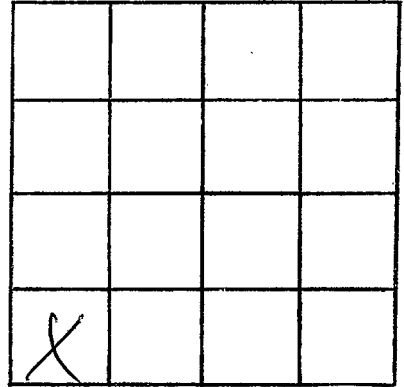

SECTION 26

Please indicate well location X.

ADDITIONAL INFORMATION

If more than one screen,
show locations of each on sketch.