

SMITH
P 11
2-23-73

MISSISSIPPI
BOARD OF WATER COMMISSIONERS
416 North State Street
Jackson, Mississippi 39201

CODED

WATER WELL DRILLERS LOG

February 23 1973 J. R. Parker Water Well Drilling Smith
date well completed firm name county well located

LANDOWNER: State
Lake Ross Burnett
Mize, Miss -
(mailing address)

description of formations encountered	from	to
red sand	0'	20'
clay	20'	20' 4"
white chalk	20' 4"	60'
red sand	60'	38'
rock	38'	88' 2"
chalk	88' 2"	95'
water sand	95'	145'

WELL LOCATION:
15 sec. 10 T. 10 N. R. 16 E. S. 4
3.074 miles S. of Mize
(distance) (direction) (nearest town)

WELL PURPOSE: lake use
(home, irrigation, municipal, industrial)

- WELL COMPLETION DATA:
- (1) diameter (inches) 2"
 - (2) total depth (feet) 115'
 - (3) static water level (feet) 20' below top of ground.
 - (4) casing PVC, 20' (material) (depth)
(size) If telescope see back.
 - (5) screen 5' (length) (depth to top)
2" (size) PVC (material)
 - (6) pump 1/4 (HP) 5 (yield gpm)
jet (type power)
 - (7) electric log (yes or no)
(organization running log)
 - (8) how well bottom plugged rock


CODED

DRILLERS REMARKS:

REGISTERED
MARCH 1 1973

If well telescopes please sketch and show depths.

GROUND LEVEL

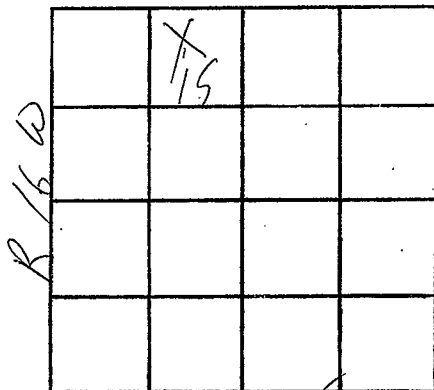

SECTION 15

Please indicate well location X.

ADDITIONAL INFORMATION

Go to Lake Ross
barometer at 1130 -
it is the Lakowell.

If more than one screen,
show locations of each on sketch.