

CODED

P. CLARK

MISSISSIPPI WATER WELL DRILLING BOARD OF WATER COMMISSIONERS ROUTE 2 416 North State Street LAUREL, MISS. 39440 Jackson, Mississippi 39201

SMITH
P12
10-5-77
E Log # 184

WATER WELL DRILLERS LOG

Smith

10/5 1977 C.P. Clark firm name date well completed
county well located

LANDOWNER: Jayne Central
Chetonna Water Assoc.
Test Hole Mine-Miss
(mailing address)

description of formations encountered	from	to
Sandy Clay	0	11
Sand	11	62
Rock	62	62 1/2
Clay	62 1/2	158
Sand	158	180
Course Sand	180	190
Sand & Clay	190	201
Sand	201	238
Clay	238	243
Rock, CODED	243	244
Clay	244	345
Rock	345	347
Clay w Soft Shales	347	533
Clay	533	735
Lime & Shell Formation	735	767
Rock	767	769
Green Clay & Shells	769	825
Sand	825	875
Clay & Green Soft Shales	875	1021

WELL LOCATION:
sec. 26 T. 19 N. R. 16 E. S. 5 W. W
4 1/2 miles SW of Mine
(distance) (direction) (nearest town)

WELL PURPOSE: Community Test Hole
(home, irrigation, municipal, industrial)

WELL COMPLETION DATA:
(1) diameter (inches) 4
(2) total depth (feet) 875
(3) static water level (feet) 168 below above top of ground.
(4) casing Black Iron 741
(material) (depth)
2 If telescope see back.
(size)
(5) screen 42 833
(length) (depth to top)
2 3/4 Solid SS 3/1600
(size) (material)
(6) pump air 150
(HP) (yield gpm)
air
(type power)
(7) electric log yes
(yes or no)
M.S. S.S.
(organization running log)
(8) how well bottom plugged BWU


RECEIVED
OCT 18 1977

MISS. BD. OF WATER COM.

DRILLERS REMARKS:

If well telescopes please sketch and show depths.

GROUND LEVEL

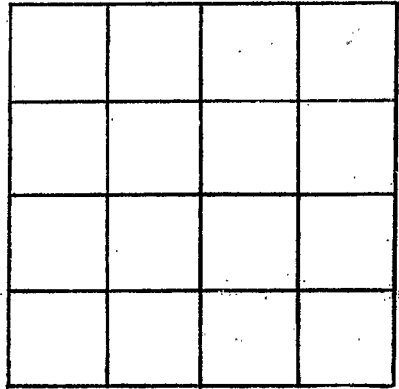

SECTION _____

Please indicate well location X.

ADDITIONAL INFORMATION

A series of horizontal lines for entering additional information.

If more than one screen, show locations of each on sketch.