

MISSISSIPPI DEPARTMENT OF NATURAL RESOURCES

Bureau of Land and Water Resources

Southport Mall

P.O. Box 10631

Jackson, Mississippi 39209

WATER WELL DRILLERS LOG

CODED

Smith
P 16
4-20-81

Griner Drilling
Service, INC

Smith


4-20-81
date well completed

Griner Drilling
Service, INC
firm name

Smith
county well located


LANDOWNER:	description of formations encountered	from	to
Midroc Operating Co. Suite 416 One Energy Sq. 4925 Greenville Ave Dallas, Texas (mailing address)	clay, rock, sand	0	412
WELL LOCATION: 1390' S 1044' W	sand	412	474
No. 1 sec. 5 T. 10 N. R. 10 E. of Yelverton West Mize ONE/COR (distance) (direction) (nearest town)	clay	474	483
WELL PURPOSE: (home, irrigation, municipal, industrial)			
WELL COMPLETION DATA:			
(1) diameter (inches) 3"			
(2) total depth (feet) 483'			
(3) static water level (feet) 140' below top of ground.			
(4) casing steel 483' (material) (depth)			
3" (size) If telescope see back.			
(5) screen 42' 441' (length) (depth to top)			
3" perforated (size) (material)			
(6) pump 65 (HP) (yield gpm)			
AC (type power)			
(7) electric log (yes or no)			
(organization running log)			
(8) how well bottom plugged orange peel			
DRILLERS REMARKS:			

CODED

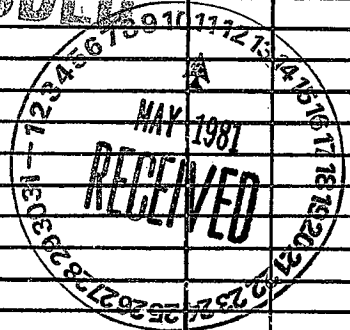

If well telescopes please sketch and show depths.

GROUND LEVEL

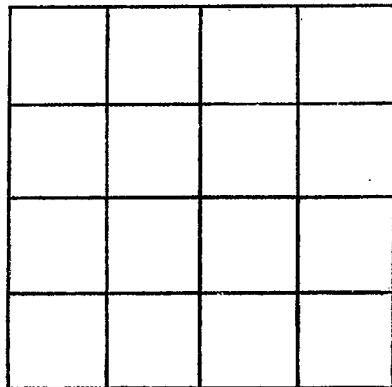

SECTION _____

Please indicate well location X.

ADDITIONAL INFORMATION

If more than one screen,
show locations of each on sketch.