

MISSISSIPPI DEPARTMENT OF NATURAL RESOURCES

Bureau of Land and Water Resources

Southport Mall

P.O. Box 10631

Jackson, Mississippi 39209

WATER WELL DRILLERS

Griner Drilling Service, Inc.

CODED

Smith

SMITH
P 17
8-4-81

8-4-81 date well completed

Griner Drilling Service, Inc. firm name

county well located

LANDOWNER:

Midroc Operating Co
Suite 116
One Energy Square
4925 Bullockville, Ave.
Dallas, TX (mailing address)

description of formations encountered

from

to

sand

0

35

sand, chalk

35

56

rock, chalk

56

203

chalk

203

434

sand

434

476

WELL LOCATION:

875154230E
sec. 4 T-10N R-16 E NW/4
Yelverton East Magee Field
4 1/4 miles (direction) of (nearest town)

WELL PURPOSE:

oil field
water supply

WELL COMPLETION DATA:

2-3" Well
Water
#1 Well
#2 Well
Same steel 476'
(material) (depth)

(1) diameter (inches) *3"*

(2) well depth (feet) *476'*

(3) static water level (feet) *20' below*
ground.

3" if telescope see back.
(size)

(5) screen *42' 434'*
(length) (depth to top)

3" *perforated*
(size) (material)

(6) pump *60*
(HP) (yield gpm)

AC
(type power)

(7) electric log (yes or no)

(organization running log)

(8) how well bottom plugged *orange*
peel

DRILLERS REMARKS:

CODED

#2 Well
the same

DEPT. OF NATURAL RESOURCES
BUREAU OF LAND & WATER RESOURCES


AUG 26 1981

RECEIVED

RECEIVED
AUG 1981
17 18 19 20 21 22 23 24 25 26 27 28 29 30 31

If well telescopes please
sketch and show depths.

GROUND LEVEL

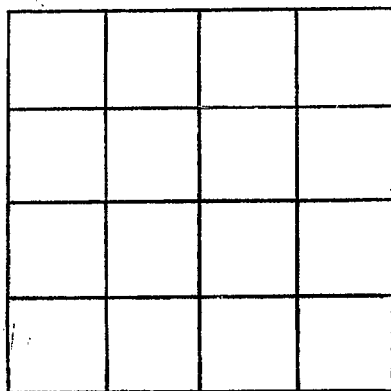

SECTION _____

Please indicate well location X.

ADDITIONAL INFORMATION

If more than one screen,
show locations of each on sketch.