

MISSISSIPPI DEPARTMENT OF NATURAL RESOURCES

Bureau of Land and Water Resources

Southport Mall

P.O. Box 10631

Jackson, Mississippi 39209

WATER WELL DRILLERS LOG

CODED

Smith
P18
10-23-81

Griner Drilling Service, Inc.

Smith

10-23-81 date well completed

Griner Drilling Service, Inc. firm name

Smith county well located

LANDOWNER:

Midroc Operating Co.
1220 Two Energy Square
4849 Greenville Avenue
Dallas, Texas (mailing address) 75206

description of formations encountered

from

to

sand, gravel

0 189

chalk, sand

189 294

WELL LOCATION: 1810'S + 2183'W

sec 5 T-10 (N) R-16 E NE/40'

sand, gravel

294 336

No. 3 Jelverton East Magee Field

chalk

336 441

5.49 miles (distance) (direction) (nearest town)

sand

441 504

WELL PURPOSE: oil field supply (home, irrigation, municipal, industrial)

WELL COMPLETION DATA:

(1) diameter (inches) 3"

(2) total depth (feet) 504'

(3) static water level (feet) 150' (below) above top of ground.

(4) casing Steel 504' (material) (depth)

3" (size) if telescope see back.

(5) screen 42' 462' (length) (depth to top)

3" (size) perforated (material)

(6) pump — 70 (HP) (yield gpm)

AC (type power)

(7) electric log — (yes or no)

(organization running log)

(8) how well bottom plugged orange

peel

DRILLERS REMARKS:

CODED


DEPT. OF NATURAL RESOURCES
BUREAU OF LAND & WATER RESOURCES

OCT 20 1981

RECEIVED

If well telescopes please sketch and show depths.

GROUND LEVEL

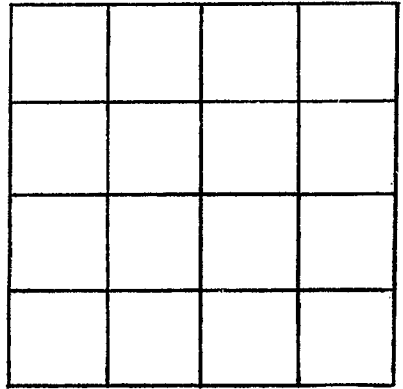

SECTION _____

Please indicate well location X.

ADDITIONAL INFORMATION

If more than one screen, show locations of each on sketch.