

MISSISSIPPI DEPARTMENT OF NATURAL RESOURCES

Bureau of Land and Water Resources

Southport Mall

P.O. Box 10631

Jackson, Mississippi 39209

WATER WELL DRILLERS LOG

Griner Drilling Service, Inc.

Smith

Smith
P 19
11-8-87

Coled

11-8-87

date well completed

firm name

county well located

LANDOWNER:

Mosbacher Energy Co.
712 Main St.
Houston, TX. 77002-3290

(mailing address)

description of formations encountered

from

to

CLAY
SAND, PEAT GRAVEL

0' *195'*

WELL LOCATION: *750' N of 2020' E*

sec. *32* T. *10* N. R. *16* E of *SP/CO*

No. 1 Federal Mt. Olive Field
distance (direction) of (nearest town)

WELL PURPOSE: *Oilfield Rio*
(home, irrigation, municipal, industrial) *Supply*

WELL COMPLETION DATA:

(1) diameter (inches) *4"*

(2) total depth (feet) *195'*

(3) static water level (feet) *65'* *below* above top of ground.

(4) casing *steel* *195'*
(material) (depth)

4"
(size) if telescope see back.

(5) screen *20'* *175'*
(length) (depth to top)

4" *stainless*
(size) (material)

(6) pump *5* *75*
(HP) (yield gpm)

230 volt 3 phase
(type power)

(7) electric log (yes or no) *(no)*

(organization running log)

(8) how well bottom plugged *4" back*
WASH VALVE


RECEIVED
JAN 4 1987

Department of Natural Resources
Bureau of Land & Water Resources

DRILLERS REMARKS:

If well telescopes please
sketch and show depths.

GROUND LEVEL

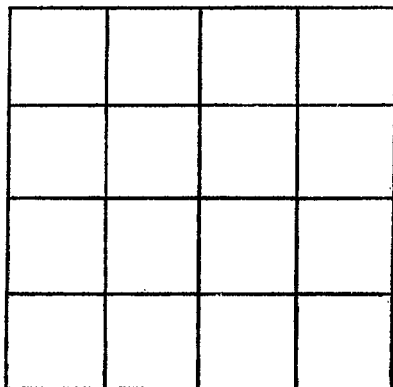

SECTION _____

Please indicate well location X.

ADDITIONAL INFORMATION

If more than one screen,
show locations of each on sketch.