

MISSISSIPPI DEPARTMENT OF NATURAL RESOURCES  
Bureau of Land and Water Resources

Southport Mall

P.O. Box 10631

Jackson, Mississippi 39209

271 CAD

WATER WELL DRILLERS LOG

Griner Drilling  
Service, Inc.

Smith

9-11-96

date well completed

firm name

county well located

LANDOWNER:

Nerco Oil + Gas, Inc.  
P.O. Box 770909  
Houston, Texas 77215-  
(mailing address) 0909

description of formations  
encountered

from

to

clay, sand, mostly clay 0 126

fine, streaked sand 126 168

WELL LOCATION:

sec. 32 T. 10 N. R. 16 E.  
6 miles South of Mize  
(distance) (direction) (nearest town)

clay, sand 168 254

sand 254 294

WELL PURPOSE: pumping station  
(home, irrigation, municipal, industrial)

WELL COMPLETION DATA:

(1) diameter (inches) 4"

(2) total depth (feet) 294'

(3) static water level (feet) 110' below  
top of ground. above

(4) casing PVC, 254'  
(material) (depth)

4"  
(size) If telescope see back.

(5) screen 40', 254' to 294'  
(length) (depth to top)

4", PVC  
(size) (material)

(6) pump 2 H.P., 230 Volt  
(HP) (yield gpm)


single phase 306 GPM  
(type power)

(7) electric log (yes or no) no

(organization running log)

(8) how well bottom plugged 4"  
backwash valve


DRILLERS REMARKS:

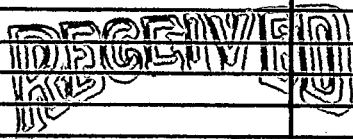

Dept. of Environmental Quality  
Bureau of Land & Water Resources

If well telescopes please  
sketch and show depths.

GROUND LEVEL

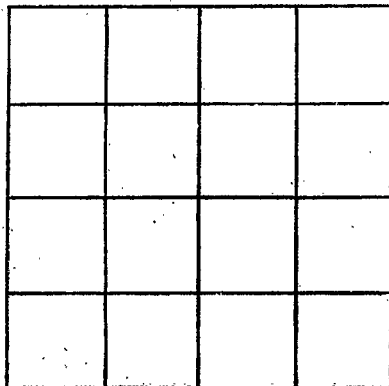

SECTION \_\_\_\_\_

Please indicate well location X.

ADDITIONAL INFORMATION

If more than one screen,  
show locations of each on sketch.