

SMITH
P 24
6-5-73

MISSISSIPPI
BOARD OF WATER COMMISSIONERS
416 North State Street
Jackson, Mississippi 39201

CODED

WATER WELL DRILLERS LOG

June 5 1973 Roy W. Smith
date well completed firm name county well located

LANDOWNER: <i>Our Siblings Baptist Church Rt 2 Mt Olive</i> (mailing address)	description of formations encountered	from	to
	Clay	0	6
	Hardy Clay	6	25
	Hard	25	45
	Clay	25	280
	Hard	280	303

WELL LOCATION:
sec. 24 T. 10 N. R. 16 E.
S W
6 miles S of MOBILE
(distance) (direction) (nearest town)

WELL PURPOSE: home
(home, irrigation, municipal, industrial)

WELL COMPLETION DATA:

(1) diameter (inches) 2

(2) total depth (feet) 303

(3) static water level (feet) 110 below
above
top of ground.

(4) casing Galv 298
(material) (depth)

(size) if telescope see back.

(5) screen 5 298
(length) (depth to top)

1/2" St Steel
(size) (material)

(6) pump 34 4
(HP) (yield gpm)

RGA
(type power)

(7) electric log no
(yes or no)


(organization running log)

(8) how well bottom plugged Leakhead

DRILLERS REMARKS: JUN 15 1973

If well telescopes please sketch and show depths.

GROUND LEVEL

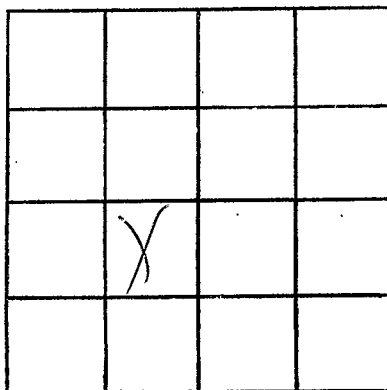

SECTION 22

Please indicate well location X.

ADDITIONAL INFORMATION

If more than one screen, show locations of each on sketch.