

MISSISSIPPI DEPARTMENT OF NATURAL RESOURCES

Bureau of Land and Water Resources

Southport Mall

P.O. Box 10631

Jackson, Mississippi 39209

WATER WELL DRILLERS LOG

**CODED**

*Griner Drilling Service, Inc.*

*Smith*

P25
Smith
9-28-83

9-28-83 date well completed

Griner Drilling Service, Inc. firm name

Smith county well located

LANDOWNER:	description of formations encountered	from	to
<i>Pruet Production Co. 217 West Capitol St. Suite 201 Jackson, MS. 39201</i> <small>(mailing address)</small>			
<b>WELL LOCATION:</b> 1500' N + 620' E OF	<i>chalk</i>	<i>84</i>	<i>231</i>
sec. <u>5</u> T. <u>10</u> N. R. <u>16</u> E SW/4 cor	<i>chalk - sand</i>	<i>231</i>	<i>336</i>
<i>No. 10</i> <u>3</u> miles <i>South Magee Field</i> <small>(distance) (direction) (nearest town)</small>	<i>sand</i>	<i>336</i>	<i>399</i>
<b>WELL PURPOSE:</b> <i>oilfield supply</i> <small>(home, irrigation, municipal, industrial)</small>			
<b>WELL COMPLETION DATA:</b>			
(1) diameter (inches) <u>3"</u>			
(2) total depth (feet) <u>399'</u>			
(3) static water level (feet) <u>120'</u> <small>(below above top of ground)</small>			
(4) casing <u>Steel</u> <u>399'</u> <small>(material) (depth)</small>			
<u>3"</u> <small>(size)</small> if telescope see back.			
(5) screen <u>42'</u> <u>357'</u> <small>(length) (depth to top)</small>			
<u>3"</u> <u>perforated</u> <small>(size) (material)</small>			
(6) pump <u>70</u> <small>(HP) (yield gpm)</small>			
<u>AC</u> <small>(type power)</small>			
(7) electric log <u> </u> <small>(yes or no)</small>			
<u> </u> <small>(organization running log)</small>			
(8) how well bottom plugged <u>Orange Field</u>			
<b>DRILLERS REMARKS:</b>			


DEPT. OF NATURAL RESOURCES  
BUREAU OF LAND & WATER RESOURCES

OCT 3 1983

**RECEIVED**

If well telescopes please sketch and show depths.

GROUND LEVEL

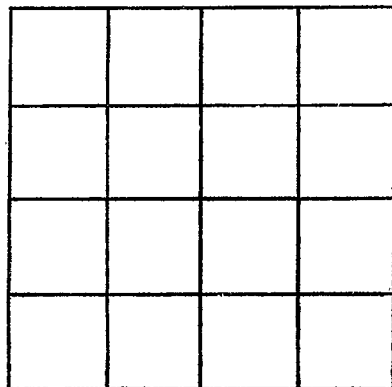

SECTION \_\_\_\_\_

Please indicate well location X.

ADDITIONAL INFORMATION

If more than one screen,  
show locations of each on sketch.