

SMITH
P27

MISSISSIPPI
BOARD OF WATER COMMISSIONERS
416 North State Street
Jackson, Mississippi 39201

CODED

WATER WELL DRILLERS LOG

May 25
date well completed

87 A-1 Drilling Service, Inc.
firm name

Smith
county well located

LANDOWNER: James Herring
Route 4,
Collins, Ms. 39428
(mailing address)

WELL LOCATION:
sec. 35 T 10 N R. 16 W
7 miles S of Naze
(distance) (direction) (nearest town)

WELL PURPOSE: Industrial
(home, irrigation, municipal, industrial)

- WELL COMPLETION DATA:
- (1) diameter (inches) 4
 - (2) total depth (feet) 190
 - (3) static water level (feet) 94 below top of ground.
 - (4) casing 4" 40pc, 178' (material) (depth)
 - (5) screen 10ft, 178' (length) (depth to top)
 - 4" Stainless Steel (size) (material)
 - (6) pump 1 (HP) 2800psi (yield gpm)
 - 230V 1ph. (type power)
 - (7) electric log no (yes or no)
 - (organization running log)
 - (8) how well bottom plugged B.W.

description of formations encountered	from	to
Red clay	0	5
Red sandy clay	5	13
Tan clay	13	21
Sand & clay mixture yellow	21	30
Sand	30	38
Hard streak	38	58 1/2
Tan clay	58 1/2	72
Sand and clay streaks	72	77
Tan clay	77	107
Sand	107	109
Clay	109	112
Sand and clay streaks	112	119
Sand	119	188
Clay	188	190

RECEIVED


JUN 01 1987

Department of Natural Resources
Bureau of Land & Water Conservation

DRILLERS REMARKS:

If well telescopes please sketch and show depths.

GROUND LEVEL

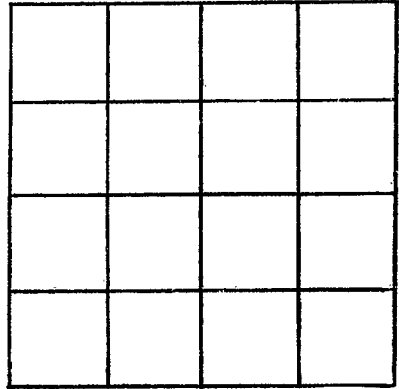

SECTION _____

Please indicate well location X.

ADDITIONAL INFORMATION

If more than one screen, show locations of each on sketch.