

Smith
 P 2000
 10-6-75

MISSISSIPPI
 BOARD OF WATER COMMISSIONERS
 416 North State Street
 Jackson, Mississippi 39201

WATER WELL DRILLERS LOG

Oct 6 1975 Roy West Washburn Smith
 date well completed firm name county well located

LANDOWNER:	description of formations encountered	from	to
Woodrow West	red clay	0	8
Rt 1	sandy clay	8	25
Mt Olive Miss	soil red	25	55
(mailing address)			

WELL LOCATION:
 sec 29 T 17 N S R 16 E
 8 miles S of Mt Olive Miss
 (distance) (direction) (nearest town)


WELL PURPOSE: home
 (home, irrigation, municipal, industrial)

- WELL COMPLETION DATA:
- (1) diameter (inches) 2 in
 - (2) total depth (feet) 55
 - (3) static water level (feet) 35 below top of ground.
 - (4) casing pvc, 50 (material), (depth), (size) if telescope see back.
 - (5) screen 5, 50 (length), (depth to top) 1/4, st steel (size), (material)
 - (6) pump 1 (HP), 8 (yield gpm) R&A (type power)
 - (7) electric log No (yes or no)
 - (organization running log)
 - (8) how well bottom plugged Washburn

DRILLERS REMARKS:

If well telescopes please sketch and show depths.

GROUND LEVEL

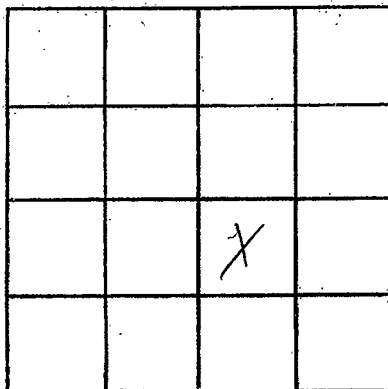

SECTION 29

Please indicate well location X.

ADDITIONAL INFORMATION

If more than one screen, show locations of each on sketch.