

SMITH
 Pool
 SMITH

MISSISSIPPI
 BOARD OF WATER COMMISSIONERS
 416 North State Street
 Jackson, Mississippi 39201

13N

WATER WELL DRILLERS LOG

3-76 1976 J.R. Green Water Well Drilling Smith
 date well completed firm name county well located

LANDOWNER:
 Tolson Harvey
 Box 214 Mt. Olive, Ms
 (mailing address)

WELL LOCATION:
 sec. 33 T. 10 N R. 16 E
 S W
 6 miles N.E. of Mt. Olive
 (distance) (direction) (nearest town)

WELL PURPOSE:
 (home, irrigation, municipal, industrial)

WELL COMPLETION DATA:

(1) diameter (inches) 4

(2) total depth (feet) 200

(3) static water level (feet) 125 below above top of ground.

(4) casing PVC 194
 (material) (depth)
 (size) if telescope see back.


(5) screen 6' 194
 (length) (depth to top)
 1/2" x 10/16" STAINLES
 (size) (material)

(6) pump 1 5
 (HP) (yield gpm)
 220 AC
 (type power)

(7) electric log NO
 (yes or no)
 (organization running log)

(8) how well bottom plugged

description of formations encountered	from to	
	feet	feet
Red Sand	0	10
" "	10	20
" "	20	30
White "	30	40
" "	40	42
White Chalk	42	50
" "	50	60
" "	60	70
" "	70	80
" "	80	90
ROCK	90	92
Pink Chalk	92	100
" "	100	110
" "	110	120
Blue "	120	130
" "	130	140
Blue Chalk	140	150
Pink Sand	150	160
" "	160	168
Blue Chalk	168	170
" "	170	180
" "	180	190
" "	190	192
SAND	192	200

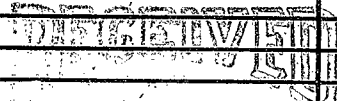


APR 20 1976

DRILLERS REMARKS:

If well telescopes please sketch and show depths.

GROUND LEVEL

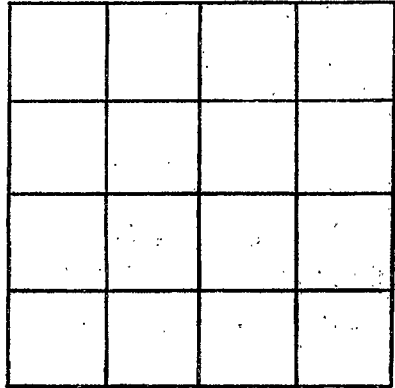

M30 + Mt. Olive Road

SECTION 33

Please indicate well location X.

ADDITIONAL INFORMATION

If more than one screen,
show locations of each on sketch.