

SMITH

P *[Signature]*

9-25-78

MISSISSIPPI
BOARD OF WATER COMMISSIONERS
416 North State Street
Jackson, Mississippi 39201

WATER WELL DRILLERS LOG

9-25 19*78* *WIK-BARNES* *Smith*
date well completed firm name county well located

LANDOWNER: *Bobby Owens*
Rt. 1
mt. olive miss
(mailing address)

description of formations encountered	from	to
<i>Red Clay</i>	<i>0</i>	<i>15</i>
<i>yellow fine sand</i>	<i>15</i>	<i>32</i>
<i>yellow clay</i>	<i>32</i>	<i>69</i>
<i>White Sand</i>	<i>69</i>	<i>92</i>

WELL LOCATION:
sec. *10 T 10 N* R *16 E*
8 miles *South* of *miss*
(distance) (direction) (nearest town)

WELL PURPOSE: *Home*
(home, irrigation, municipal, industrial)

- WELL COMPLETION DATA:
- (1) diameter (inches) *2*
 - (2) total depth (feet) *97*
 - (3) static water level (feet) *51* below top of ground.
 - (4) casing *Plastic*, *88*
(material) (depth)
2" if telescope see back.
(size)
 - (5) screen *6'*,
(length) (depth to top)
6/8, *S.S.*
(size) (material)
 - (6) pump *1-H.P*, *8*
(HP) (yield gpm)
Elec.
(type power)
 - (7) electric log *NO*
(yes or no)
(organization running log)
 - (8) how well bottom plugged *wash valve*


DRILLERS REMARKS:

RECEIVED
OCT 10 1978

MISS. Bd. OF WATER COMM

If well telescopes please sketch and show depths.

GROUND LEVEL

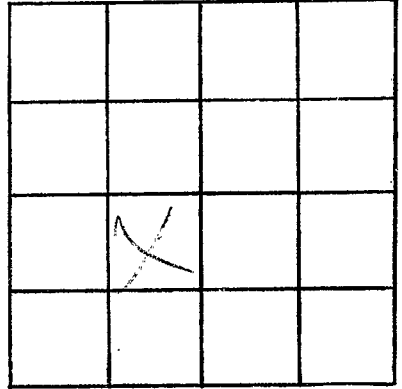

SECTION 10

Please indicate well location X.

ADDITIONAL INFORMATION

If more than one screen,
show locations of each on sketch.