

Smith
P 2003
6-24-79

MISSISSIPPI
BOARD OF WATER COMMISSIONERS
416 North State Street
Jackson, Mississippi 39201

WATER WELL DRILLERS LOG

SMITH

6-24 1979 Ray West water wells Covington
date well completed firm name county well located

LANDOWNER: James Ferguson Rt 4 Collins 39428 (mailing address)	description of formations encountered Red clay Sandy clay Sand	from	to
		0	10
		10	60
		60	92

WELL LOCATION:
sec. 33 T. 10 N. R. 16 E
5. miles N.E. of Mt. Allen
(distance) (direction) (nearest town)

WELL PURPOSE: home
(home, irrigation, municipal, industrial)

- WELL COMPLETION DATA:
- (1) diameter (inches) 2
 - (2) total depth (feet) 92
 - (3) static water level (feet) 55 below above top of ground.
 - (4) casing PVC 87
(material) (depth)
(size) if telescope see back.
 - (5) screen 5 87
(length) (depth to top)
1/4" steel
(size) (material)
 - (6) pump 1 7
(HP) (yield gpm)
RCA
(type power)
 - (7) electric log No.
(yes or no)
- (organization running log)

(8) how well bottom plugged wash
DRILLERS REMARKS:


Miss. Board of Water Comm.

JUL 16 1979

RECEIVED

If well telescopes please sketch and show depths.

GROUND LEVEL

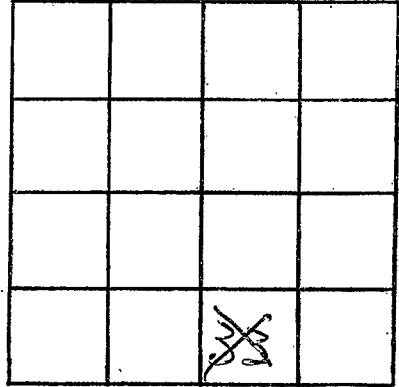

SECTION 33

Please indicate well location X.

ADDITIONAL INFORMATION

If more than one screen, show locations of each on sketch.