

SMITH
 P 2004
 12-18-79

MISSISSIPPI
 BOARD OF WATER COMMISSIONERS
 416 North State Street
 Jackson, Mississippi 39201

WATER WELL DRILLERS LOG

12-18 1979 Roy West Well Drllg Smith
 date well completed firm name county well located

LANDOWNER: <u>L.L. CLARK</u>	description of formations encountered	from	to
<u>Rt 2 Box 223</u>			
<u>Mize MS.</u> (mailing address)	<u>SAND</u>	<u>10'</u>	<u>190'</u>
WELL LOCATION:			
sec. <u>13</u> T. <u>10</u> N R. <u>16</u> E S W			
<u>5</u> miles <u>S</u> of <u>MIZE</u> (distance) (direction) (nearest town)			
WELL PURPOSE: <u>HOME</u> (home, irrigation, municipal, industrial)			
WELL COMPLETION DATA:			
(1) diameter (inches) <u>4"</u>			
(2) total depth (feet) <u>190'</u>			
(3) static water level (feet) <u>135'</u> below above top of ground.			
(4) casing <u>PVC</u> , <u>180'</u> (material) (depth)			
_____ If telescope see back. (size)			
(5) screen <u>10'</u> (length) (depth to top)			
<u>2"</u> , <u>Stainless Steel</u> (size) (material)			
(6) pump <u>1</u> <u>20</u> (HP) (yield gpm)			
<u>Electric</u> (type power)			
(7) electric log <u>NO</u> (yes or no)			
_____ (organization running log)			
(8) how well bottom plugged <u>WASH VALVE</u>			

DEPT. OF NATURAL RESOURCES
 BUREAU OF LAND & WATER RESOURCES


JAN 25 1980

RECEIVED

DRILLERS REMARKS:

If well telescopes please sketch and show depths.

GROUND LEVEL

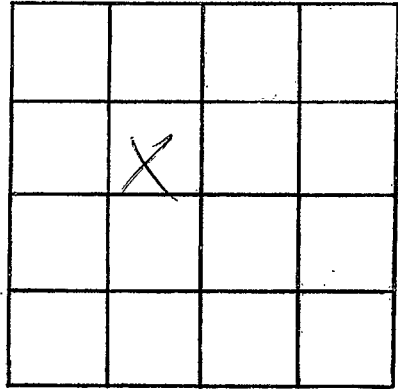

SECTION 13

Please indicate well location X.

ADDITIONAL INFORMATION

If more than one screen, show locations of each on sketch.