

SMITH
P 2005
11-11-80

MISSISSIPPI
BOARD OF WATER COMMISSIONERS
416 North State Street
Jackson, Mississippi 39201

WATER WELL DRILLERS LOG

Nov 11 1980 Roy V. West Drlg Smith
date well completed firm name county well located


LANDOWNER:	description of formations encountered	from	to
John McGee Mize (mailing address)			
WELL LOCATION: sec. 14 T 10 N R 16 E S S W S miles S of MIZE (distance) (direction) (nearest town)			
WELL PURPOSE: HOME (home, irrigation, municipal, industrial)			
WELL COMPLETION DATA:			
(1) diameter (inches) 4"			
(2) total depth (feet) 81'			
(3) static water level (feet) 21' below top of ground.			
(4) casing PVC, 71' (material) (depth)			
(size) if telescope see back.			
(5) screen 10' 71' (length) (depth to top)			
4" PVC (size) (material)			
(6) pump 1/2 20 (HP) (yield gpm)			
REA (type power)			
(7) electric log NO (yes or no)			
(organization running log)			
(8) how well bottom plugged WASH VALVE			
DRILLERS REMARKS:			

DEPT. OF NATURAL RESOURCES
BUREAU OF LAND & WATER RESOURCES

NOV 24 1980
RECEIVED

If well telescopes please sketch and show depths.

GROUND LEVEL

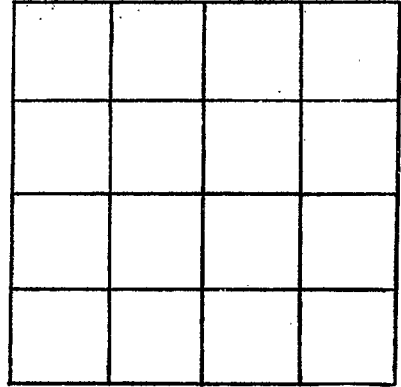

SECTION _____

Please indicate well location X.

ADDITIONAL INFORMATION

If more than one screen, show locations of each on sketch.