

SMITH
P 2000

MISSISSIPPI
BOARD OF WATER COMMISSIONERS
416 North State Street
Jackson, Mississippi 39201

WATER WELL DRILLERS LOG

4-19 1984 Roy V. West Dalg Smith
date well completed firm name county well located

LANDOWNER:	description of formations encountered	from	to
<u>LESTER LUY</u>			
<u>MT OLIVE MS</u> (mailing address)	<u>CLAY</u>	<u>3</u>	<u>18</u>
	<u>SAND</u>	<u>18</u>	<u>114</u>

WELL LOCATION:
sec. 27 T 10 N R 16 E
S W
4 miles NE of MT OLIVE
(distance) (direction) (nearest town)

WELL PURPOSE: Chicken House
(home, irrigation, municipal, industrial)

- WELL COMPLETION DATA:
- (1) diameter (inches) 2"
 - (2) total depth (feet) 114'
 - (3) static water level (feet) 75' below above top of ground.
 - (4) casing PVC, 109'
(material) (depth)
2"
(size) If telescope see back.
 - (5) screen 5', 109'
(length) (depth to top)
2" PVC
(size) (material)
 - (6) pump 1 6
(HP) (yield gpm)
REA
(type power)
 - (7) electric log no
(yes or no)
- (organization running log)
- (8) how well bottom plugged WASH VALVE

DRILLERS REMARKS:


DEPT. OF NATURAL RESOURCES
BUREAU OF LAND & WATER RESOURCES

MAY 4 1984

RECEIVED

If well telescopes please sketch and show depths.

GROUND LEVEL

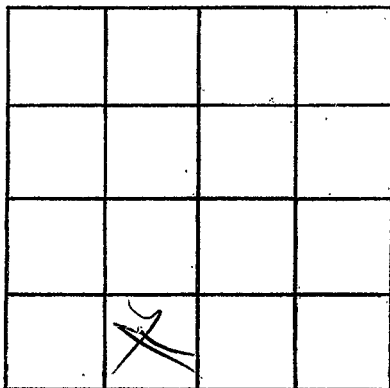

SECTION 27

Please indicate well location X.

ADDITIONAL INFORMATION

If more than one screen, show locations of each on sketch.