

MISSISSIPPI DEPARTMENT OF NATURAL RESOURCES

Bureau of Land and Water Resources

P.O. Box 10631

Jackson, Mississippi 39209

WATER WELL DRILLERS LOG

COUNTY, WELL LOCATED Smith	
WELL NUMBER P	CODED
DATE WELL COMPLETED 2-2-90	

PERMIT NUMBER
NAME OF DRILLING FIRM Roy V. West Drilling

NAME & MAILING ADDRESS OF LANDOWNER GARY TRAVIS RA 4 Box 159 Magee 39119			
WELL LOCATION	SEC	TOWNSHIP	RANGE
	6	10 ^N _S	16 ^E _W
DISTANCE	DIRECTION	NEAREST TOWN	
5 Miles	W	of MIZE	
OTHER LANDMARK			
WELL PURPOSE: Home, Irrigation, Municipal, Industrial, Fish Pond, etc. Poultry Farm			

PUMP DATA		
PUMP TYPE (Circle One): Submersible , Turbine, Jet, Flowing Well, Other (Describe) _____		
POWER TYPE (Circle One): Electric , Tractor, Diesel, Gasoline, Butane, Other (Describe) _____ H/P _____		
Pump Capacity (GPM) 18	No. of Stages	Setting Depth 140' FT.
PUMP TEST		
Well yielded 25 GPM with a drawdown of _____ ft. after _____ hours of pumping		

WELL DATA		
Well Depth 150'	Casing Diameter (In.) 4"	Casing Length (Ft.) 140'
Type of Casing PVC	Hole Depth 150'	Depth to Static Water Level 90'
TYPE OF COMPLETION: (Circle One or More): Gravel Packed, Underreamed, Telescoped, Natural Development , Open Hole, Other		
Top of Lap Pipe or Reduction in Casing		
FEET IF TELESCOPED OR MORE THAN ONE SCREEN: USE BACK PAGE		


LOG DATA	
TYPE OF LOG RUN (Circle One): Electric, Gamma Ray, Density, Sonic, Neutron, Other (Describe) _____ No Log Run	
Name of Organization Running Log	

SCREEN DATA		
Diameter - Inches 4"	Length - Feet 10'	Slot Size - Inches .010
Screen Type PVC	Depth to Bottom - Feet 150'	

GEOLOGIC DATA (Office Use Only)			
Surface Elev.	Geologic Unit	Unit Thickness	Depth to Top
Subs. SWL	Date	Analysis	Aquifer Test

Driller's Remarks	

DESCRIPTION OF FORMATIONS ENCOUNTERED	FROM	TO
SANDY CLAY	0	21
SAND, GRAVEL	21	92
CLAY	92	105
SAND	105	150

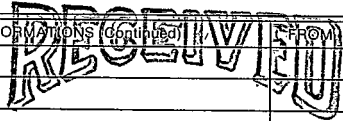

APR 23 1990

Department of Natural Resources
Bureau of Land & Water Resources

FORMATIONS (continued)	FROM	TO

IF MORE SPACE IS NEEDED, USE BACK

If well telescopes please sketch and show depths.

GROUND LEVEL

	X		

SECTION 6

Please indicate well location X.

ADDITIONAL INFORMATION

If more than one screen,
show location of each on sketch.