

MISSISSIPPI DEPARTMENT OF NATURAL RESOURCES

Bureau of Land and Water Resources

P.O. Box 10631

Jackson, Mississippi 39209

WATER WELL DRILLERS LOG

COUNTY WELL LOCATED Smith	
WELL NUMBER 203	CODED
DATE WELL COMPLETED 6-12-90	

PERMIT NUMBER
NAME OF DRILLING FIRM Roy V. West

NAME & MAILING ADDRESS OF LANDOWNER Jimmy Brewer			
Rt 2			
Mize MS			
WELL LOCATION:	SEC	TOWNSHIP	RANGE
	11	10^N	16^E
DISTANCE	DIRECTION	NEAREST TOWN	
2 Miles	SW	of MIZE	
OTHER LANDMARK			
WELL PURPOSE: Home, Irrigation, Municipal, Industrial, Fish Pond, etc. Poultry Farm			

PUMP DATA		
PUMP TYPE (Circle One): Submersible Turbine, Jet Flowing Well, Other (Describe) _____		
POWER TYPE (Circle One): Electric Tractor, Diesel, Gasoline, Butane, Other (Describe) _____ H/P 1		
Pump Capacity (GPM) 25	No. of Stages	Setting Depth 50' FT.
PUMP TEST. Well yielded _____ GPM with a drawdown of _____ ft. after _____ hours of pumping		


WELL DATA		
Well Depth 52'	Casing Diameter (In.) 4"	Casing Length (Ft.) 43'
Type of Casing PVC	Hole Depth 53'	Depth to Static Water Level 4'
TYPE OF COMPLETION: (Circle One or More): Natural Development Gravel Packed, Underreamed, Telescoped, Open Hole, Other		
Top of Lap Pipe or Reduction in Casing FEET IF TELESCOPED OR MORE THAN ONE SCREEN: USE BACK PAGE		

LOG DATA	
TYPE OF LOG RUN (Circle One): Electric, Gamma Ray, Density, Sonic, Neutron, Other (Describe) _____ No Log Run	
Name of Organization Running Log	

SCREEN DATA		
Diameter - Inches 4"	Length - Feet 10	Slot Size - Inches .010
Screen Type PVC		Depth to Bottom - Feet 53'

GEOLOGIC DATA (Office Use Only)			
Surface Elev.	Geologic Unit	Unit Thickness	Depth to Top
Subs. SWL	Date	Analysis	Aquifer Test

Driller's Remarks

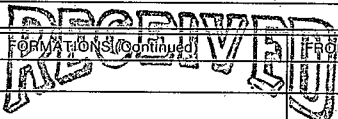

DESCRIPTION OF FORMATIONS ENCOUNTERED	FROM	TO	FORMATION(S) (continued)	FROM	TO
SANDY CLAY	0	7			
SAND	7	53			
IF MORE SPACE IS NEEDED, USE BACK					

Department of Natural Resources
Bureau of Land & Water Resources

If well telescopes please sketch and show depths.

GROUND LEVEL

	X		

SECTION 11

Please indicate well location X.

ADDITIONAL INFORMATION

If more than one screen,
show location of each on sketch.