

MISSISSIPPI DEPARTMENT OF ENVIRONMENTAL QUALITY
Bureau of Land and Water Resources

P. O. Box 10631
Jackson, MS 39289-0631
WATER WELL DRILLERS LOG

COUNTY WELL LOCATED
SMITH

WELL NUMBER **1P** CODED

DATE WELL COMPLETED
2023
1-10-92

PERMIT NUMBER

NAME OF DRILLING FIRM
PARKER WELL SERVICE
TAYLORSVILLE MS.

NAME & MAILING ADDRESS OF LANDOWNER
DURWOOD ADCOCK
RT. 1 MIZE MS.

WELL LOCATION: SEC **2** TOWNSHIP **10** RANGE **16**
UNKNOWN S E W

DISTANCE **1 1/2** Miles DIRECTION **WEST** of NEAREST TOWN **MIZE**

OTHER LANDMARK
FISH POND ON 28 HW.
FISH ~~AND~~ POND

WELL PURPOSE: Home, Irrigation, Municipal, Industrial, Fish Pond, etc.
FISH ~~AND~~ POND

PUMP DATA

PUMP TYPE (Circle One):
 Submersible, Turbine, Jet, Flowing Well,
Other (Describe)

POWER TYPE (Circle One):
Electric, Tractor, Diesel, Gasoline, Butane,
Other (Describe) H/P **1**

Pump Capacity (GPM) **20** No. of Stages **10** Setting Depth **100'** FT.

PUMP TEST
Well yielded **30** GPM with
a drawdown of **DRAW DOWN** ft.
SEAL SET @ 90'
after _____ hours of pumping

WELL DATA

Well Depth 160'	Casing Diameter (In.) 4"	Casing Length (Ft.) 150'
Type of Casing PVC	Hole Depth 4"	Depth to Static Water Level 30'

TYPE OF COMPLETION: (Circle One or More):
 Gravel Packed, Underreamed, Telescoped,
 Natural Development, Open Hole, Other
(Describe)

Top of Lap Pipe or Reduction in Casing

FEET IF TELESCOPED OR MORE THAN ONE SCREEN: USE BACK PAGE

LOG DATA

TYPE OF LOG RUN (Circle One): No Log Run,
Electric, Gamma Ray, Density, Sonic, Neutron,
Other (Describe)

Name of Organization Running Log

SCREEN DATA

Diameter - Inches 4"	Length - Feet 10'	Slot Size - Inches 0.10
Screen Type PVC	Depth to Bottom - Feet 160	

GEOLOGIC DATA (Office Use Only)

Surface Elev.	Geologic Unit	Unit Thickness	Depth to Top
Subs. SWL	Date	Analysis	Aquifer Test

Driller's Remarks


DESCRIPTION OF FORMATIONS ENCOUNTERED	FROM	TO	FORMATIONS CONTINUED	FROM	TO
CLAY	0	10	DISCOVERY JAN 15 1992		
CORSE SAND	10	40			
CHALK	40	100			
SAND	100	130			
CHALK	130	135			
SAND	135	160			

Dept. of Environmental Quality
Bureau of Land & Water Resources

IF MORE SPACE IS NEEDED, USE BACK

If well telescopes please
sketch and show depths.

GROUND LEVEL

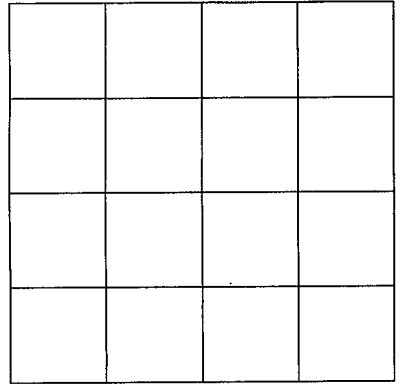

SECTION _____

Please indicate well location X.

ADDITIONAL INFORMATION

If more than one screen,
show location of each on sketch.