


If well telescopes please sketch and show depths.

GROUND LEVEL

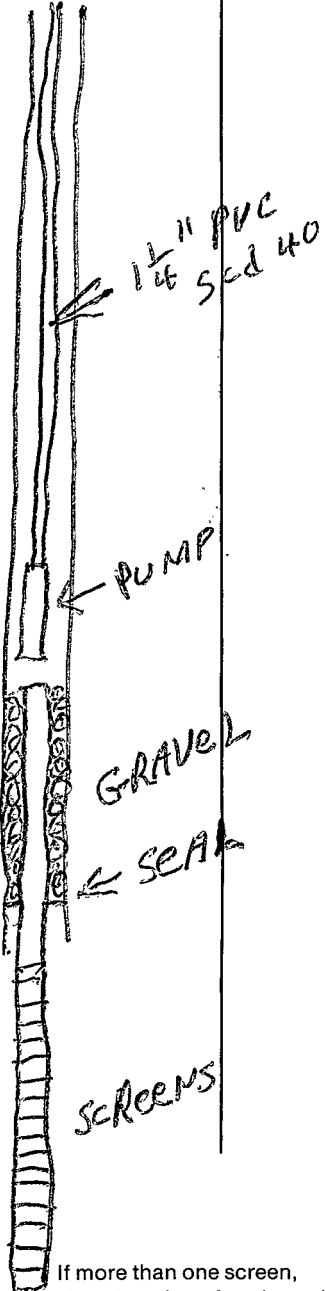

If more than one screen, show location of each on sketch.

TION

			25

R16W

SECTION 25

Please indicate well location X.

ADDITIONAL INFORMATION

GOTO MIZE GO
SOUTH ON 35 HWY
TO NEW HAVEN
OLD SCHOOL TAKE
LEFT HOUSE AND
FIELD ON LEFT