

SMITH

MISSISSIPPI BOARD OF WATER COMMISSIONERS

Q 3

8-30-60

WATER WELL DRILLERS LOG

Q-300 6

Date: 8-30, 1960 Driller: W. K. Barnes County Smith

(Name)

(1) Owner of Land Robert McWilliams

(Name)

Route 3 Taylorsville

(Address)

(2) Location: unknown 1/4 Sec 14 T. R.

2 1/2 miles West of Taylorsville

(distance)

(direction)

(Nearest Town)

(3) Topography: Hilly

(Hilly)

(Flat)

(Level)

(4) Purpose of Well: Home use

(Domestic Irrigation, Municipal, Industrial, Other)

Description & Color of Materials Sand, Clay, Red Clay, Shell, etc.	Thick- ness Feet	Depth Feet
Red Clay	0	30
Yellow Clay	30	100
Water Sand	10	128

Information upon completion of well:

(1) Diameter 2 inches.

(2) Total Depth 128 feet.

(3) Water Level 40 feet below top of ground.

(4) Cased to 122, Size 2

(5) Screen: Size 60, Length 6


(6) Were any formations sealed against pollution?

yes, no.

If YES depth of formation

Why

Drillers Remarks:

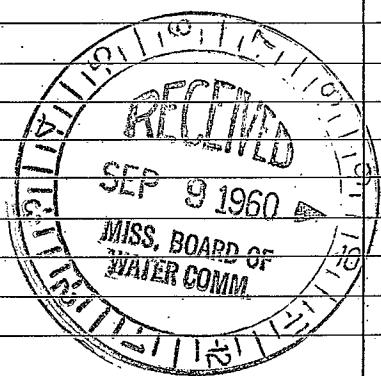

(Use Back Side)

Well No.

