

#76 SMITH

MISSISSIPPI BOARD OF WATER COMMISSIONERS

20

Q5
2-8-62

WATER WELL DRILLERS LOG

Date: 2/8, 1962, Driller: Wynona White County Smith
(Name)

(1) Owner of Land:	Description & Color of Materials: Sand, Clay, Red Clay, Shell, etc.	Thick- ness Feet	Depth Feet
<u>Lidley Smith</u> (Name) <u>Miss, Miss</u> (Address)	<u>Red Clay</u> <u>Sand</u> <u>mostly sand</u>	<u>20</u> <u>45</u> <u>14</u>	<u>20</u> <u>65</u> <u>79</u>
(2) Location: <u>1/4</u> , <u>1/4</u> , Sec. <u>6</u> <u>T11R #11</u> <u>city of</u> miles, of <u>Miss</u> (distance), (direction), (Nearest Town)			
(3) Topography: <input checked="" type="checkbox"/> (Hilly) <input type="checkbox"/> (Flat) <input type="checkbox"/> (Level)			
(4) Purpose of Well: (Domestic Irrigation, Municipal, Industrial, Other)			


Information upon completion of well:

- (1) Diameter 2 inches.
- (2) Total Depth 79 feet.
- (3) Water Level 65 feet below top of ground.
- (4) Cased to 63, Size 21'
- (5) Screen: Size 1 1/2", Length 6 ft
- (6) Were any formations sealed against pollution?
_____ yes, _____ no.

If YES depth of formation _____

Why _____

Drillers Remarks: _____

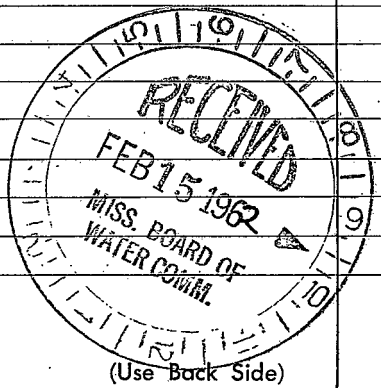

Well No.

[The page contains extremely faint and illegible text, likely bleed-through from the reverse side of the document. No specific words or phrases can be discerned.]