

Q 7

7-28-60

7

0

WATER WELL DRILLERS LOG

Date: July 28, 1960, Driller: James Smith County Smith
(Name)

(1) Owner of Land: P. R. Bastian
(Name)

Tombersville
(Address)

(2) Location: 1/4, 1/4, Sec. 13 T R
10N 15W

2 miles West of Tombersville
(distance) (direction) (Nearest Town)

(3) Topography: H
(Hilly) (Flat) (Level)

(4) Purpose of Well: Domestic
(Domestic Irrigation
Municipal, Industrial, Other)

Description & Color of Materials
Sand, Clay, Red Clay, Shell, etc.

Thick-
ness
Feet

Depth
Feet

Description & Color of Materials Sand, Clay, Red Clay, Shell, etc.	Thick-ness Feet	Depth Feet
<u>Obs.</u>	<u>15</u>	
<u>Shells</u>	<u>50</u>	
<u>Gravel</u>	<u>15</u>	<u>80</u>

Information upon completion of well:

(1) Diameter 4 inches.

(2) Total Depth 80 feet.

(3) Water Level 60 feet below top of ground.

(4) Cased to 74, Size 2

(5) Screen: Size 1/4, Length 6 ft.


(6) Were any formations sealed against pollution?

X yes, no.

If YES depth of formation _____

Why _____

Drillers Remarks: _____

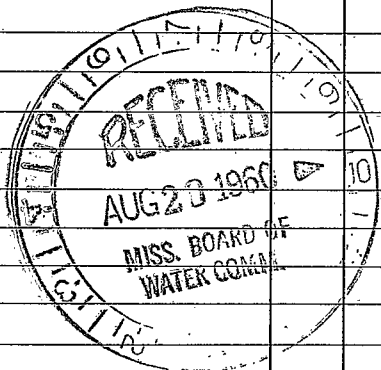

(Use Back Side)

Well No.

