

Smith
 Q8 CODED
 3-67

MISSISSIPPI
 BOARD OF WATER COMMISSIONERS
 416 North State Street
 Jackson, Mississippi 39201

WATER WELL DRILLERS LOG

3-24 1967 W.K. Barnes water wells Smith
 date well completed firm name county well located

L. ANDOWNER: Donace Anderson
 Rt. 1
 Taylorsville Miss.
 (mailing address)

description of formations encountered	from	to
Red Clay	0	5'
yellow clay	5'	40
Rock	40	42
yellow clay	42	60
fine sand	60	80
Course Sand	80	92

WELL LOCATION:
 sec. 3 T. 10 N. R. 15 E.
 4 miles East of ^W miles Miss.
 (distance) (direction) (nearest town)

WELL PURPOSE: Home
 (home, irrigation, municipal, industrial)

WELL COMPLETION DATA:

- (1) diameter (inches) 2
- (2) total depth (feet) 92
- (3) static water level (feet) 45 below above top of ground.
- (4) casing Galv., 87,
 (material) (depth)
2" if telescope see back.
 (size)
- (5) screen 5', 92
 (length) (depth to top)
08 dot, Stainless Steel
 (size) (material)
- (6) pump 3/4, 10
 (HP) (yield gpm)
Elec.
 (type power)
- (7) electric log no
 (yes or no)

 (organization running log)
- (8) how well bottom plugged washed


CODED

APR 28 1968
 MISS. BOARD OF
 WATER COMMISSIONERS

DRILLERS REMARKS:

If well telescopes please sketch and show depths.

GROUND LEVEL

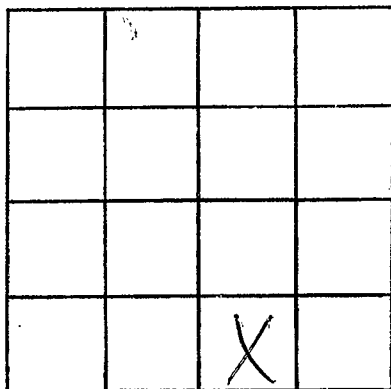

SECTION 3

Please indicate well location X.

ADDITIONAL INFORMATION

If more than one screen, show locations of each on sketch.