

Smith  
 Q 9 CODED  
 2-67

MISSISSIPPI  
 BOARD OF WATER COMMISSIONERS  
 416 North State Street  
 Jackson, Mississippi 39201

WATER WELL DRILLERS LOG

July 3 1967 W. K. Barnes Water Well Smith  
 Date well completed firm name county well located

LANDOWNER:	description of formations encountered	from	to
L. B. Rutland Saylorville Miss. Rt. 1 (mailing address)			

WELL LOCATION:  
 sec. 25 T 10 N R 15 E  
 S W  
 6 miles South of Saylorville  
 (distance) (direction) (nearest town)

WELL PURPOSE:  
 (home, irrigation, municipal, industrial)

WELL COMPLETION DATA:

(1) diameter (inches) 2  
 (2) total depth (feet) 73  
 (3) static water level (feet) 41 <sup>below</sup> top of ground.  
 (4) casing 2" Galv. 109 ft. (material) (depth)  
 2" If telescope see back. (size)  
 (5) screen 4 ft. 73 ft. (length) (depth to top)  
 8 Slot, Stainless S. (size) (material)  
 (6) pump 1 15 (HP) (yield gpm)  
 Elec. (type power)  
 (7) electric log no. (yes or no)  
 (organization running log)

CODED

JUN 27 1968  
 MISS. BOARD OF  
 WATER COMM.


(8) how well bottom plugged Wash Well  
 DRILLERS REMARKS:

If well telescopes please sketch and show depths.

GROUND LEVEL

69  
~~73~~ ft. 2"

4 ft. Stainless

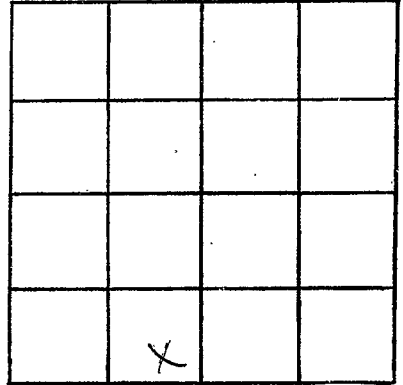

SECTION 2.5

Please indicate well location X.

ADDITIONAL INFORMATION

If more than one screen, show locations of each on sketch.