

CODED

CODED

CODED

CODED

MISSISSIPPI BOARD OF WATER COMMISSIONERS

416 North State Street

Jackson, Mississippi 39201

CODED

CODED

WATER WELL DRILLERS LOG

Smith  
Q 10  
10-23-68

10-23 date well completed  
1968 W.K. Barnes water wells firm name  
Smith county well located

LANDOWNER: E. V. Gibson

description of formations encountered

from to

Ritzline  
Miss. Miss.  
(mailing address)

Red clay	0	5
yellow clay	5	18
Red sand	18	27
yellow clay	27	40
peck	40	42
yellow clay	42	46
water sand	46	59

WELL LOCATION:  
sec. 15 T. 10 N R. 15 E  
S W  
3 miles East of Miss.  
(distance) (direction) (nearest town)

WELL PURPOSE: Home  
(home, irrigation, municipal, industrial)

WELL COMPLETION DATA:

- (1) diameter (inches) 2
- (2) total depth (feet) 59
- (3) static water level (feet) 21 below above top of ground.
- (4) casing Galv. 54 (material) (depth)  
1 1/4 (size) if telescope see back.
- (5) screen 5 ft. (length) (depth to top)  
8 slot, Stainless Steel (size) (material)
- (6) pump 1/2 (HP) 8 (yield gpm)  
Elec. (type power)
- (7) electric log no (yes or no)

(organization running log)


(8) how well bottom plugged Wash. Valve

DRILLERS REMARKS:

DEC - 5 1968  
MISS. Bd. of WATER COMMISSIONERS

If well telescopes please sketch and show depths.

GROUND LEVEL

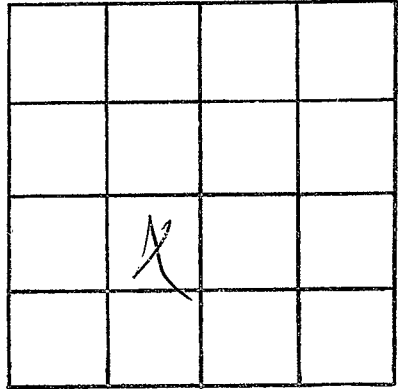

SECTION 15

Please indicate well location X.

ADDITIONAL INFORMATION

If more than one screen, show locations of each on sketch.