

Smith  
 911  
 1-13-69

MISSISSIPPI  
 BOARD OF WATER COMMISSIONERS  
 416 North State Street  
 Jackson, Mississippi 39201

CODED

WATER WELL DRILLERS LOG

1-13 1969 W.K. Barnes Water wells Smith  
 date well completed firm name county well located

LANDOWNER: L.D. Craft

description of formations encountered

from to

Miss Miss.

red clay

0 12

red sand

12 30

yellow clay

30 90

Rock

90 95

yellow clay

95 115

fine sand

115 150

water sand

150 172

(mailing address)

WELL LOCATION:

sec. 9 T. 10 N R. 15 E  
 4 miles E of Miss Miss.  
 (distance) (direction) (nearest town)

WELL PURPOSE: Home  
 (home, irrigation, municipal, industrial)

WELL COMPLETION DATA:

- (1) diameter (inches) 2
- (2) total depth (feet) 172
- (3) static water level (feet) 80 below top of ground.
- (4) casing Galv. (material), (depth), 2" (size) if telescope see back.
- (5) screen 4 ft. (length), (depth to top) 8 slot, Stainless Steel (size), (material)
- (6) pump Air Compressor 20 (HP) (yield gpm) Elec (type power)
- (7) electric log no (yes or no)

CODED

(organization running log)

(8) how well bottom plugged wash valve


FEB - 5 1969

DRILLERS REMARKS:

MISS. BD. OF  
 WATER COMM.

If well telescopes please sketch and show depths.

GROUND LEVEL

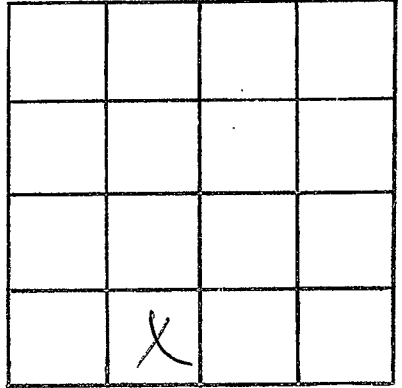

SECTION 9

Please indicate well location X.

ADDITIONAL INFORMATION

If more than one screen, show locations of each on sketch.