

SMITH
Q 13
2-11-69

MISSISSIPPI
BOARD OF WATER COMMISSIONERS
416 North State Street
Jackson, Mississippi 39201

CODED

WATER WELL DRILLERS LOG

Smith

2-11-69 date well completed 1969 W.K. Bowen Water Works firm name county well located

LANDOWNER: Carl Parker
Route 1
Jouglessville, Missouri
(mailing address)

description of formations encountered	from	to
Red Clay	0	8
Red Sand	8	30
yellowed clay	30	60
fine sand	60	90
Coarse sand	90	109

WELL LOCATION:
sec. 32 T-10N R-15E
S W
4 miles South W. Jouglessville
(distance) (direction) (nearest town)

WELL PURPOSE: Home
(home, irrigation, municipal, industrial)

WELL COMPLETION DATA:

(1) diameter (inches) 2

(2) total depth (feet) 109

(3) static water level (feet) 125 below above top of ground.

(4) casing Galv. (material), (depth), 1 1/4" (size) if telescope see back.

(5) screen 5' (length), (depth to top) 88 shot, 3/4 inch S. (size) (material)

(6) pump 1 (HP), 1/2 (yield gpm)
Elec (type power)

(7) electric log Yes (yes or no)

(organization running log)

CODED

APR - 1 1969


(8) how well bottom plugged wash water

MISS. BD. OF WATER COM.

DRILLERS REMARKS:

If well telescopes please sketch and show depths.

GROUND LEVEL

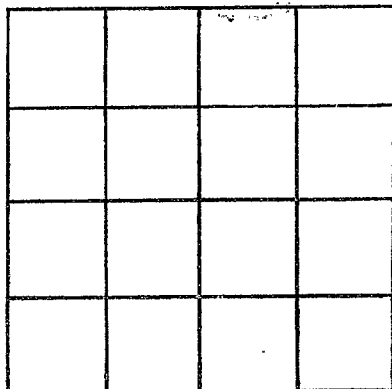

SECTION _____

Please indicate well location X.

ADDITIONAL INFORMATION

If more than one screen, show locations of each on sketch.