

T.M.P.A.

CODED

MISSISSIPPI
 BOARD OF WATER COMMISSIONERS
 416 North State Street
 Jackson, Mississippi 39201

WATER WELL DRILLERS LOG

Smith
 Q 14
 5-69

May 27 1969 W. G. Butler Smith
 date well completed firm name county well located

LANDOWNER:

Georgia Pacific
 Taylorsville, Miss.
 (mailing address)

description of formations encountered

from to

WELL LOCATION:

sec 13 T 10 N R 15 W
 1/2 miles West of Taylorsville
 (distance) (direction) (nearest town)

WELL PURPOSE:

Industrial

WELL COMPLETION DATA:

- (1) diameter (inches) 4
- (2) total depth (feet) 410
- (3) static water level (feet) 78 (below top of ground)
- (4) casing Black, 189' 4" (material) (depth) 147' 2 1/2"
 4 x 2 1/2" of telescope see back. (size)
- (5) screen 80' 336' (length) (depth to top)
 2 1/2" S.S. (size) (material)
- (6) pump 3 35 (HP) (yield gpm)
 Electric (type power)
- (7) electric log Yes (yes or no)
 (organization running log)
- (8) how well bottom plugged 2 1/2" B.W.V.

Chalk	1	5
Sand-rock-clay	5	25
Sand	25	35
Rock	35	55
Chalk & Rock	55	75
Chalk	75	135
Sand	135	165
Rock & Chalk	165	170
Cavity	170	175
Sand	175	200
Clay	200	206
Sand	206	221
Rock & Chalk	221	242
Rock	242	263
Rock & Chalk	263	300
Sand & Clay	300	305
Sand	305	347
(good) Sand	347	410


DRILLERS REMARKS:

AUG 4 1969


MISS. RD. OF WATER COMM.

If well telescopes please sketch and show depths.

GROUND LEVEL

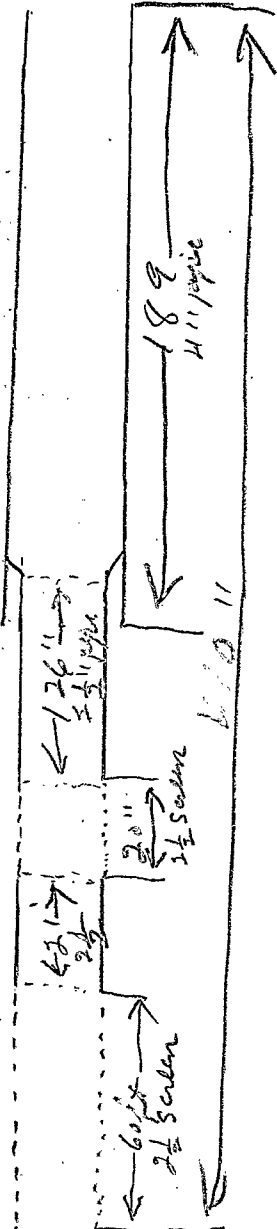

If more than one screen, show locations of each on sketch.

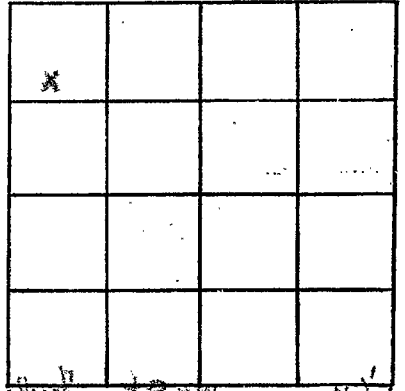

SECTION 13

Please indicate well location X.

ADDITIONAL INFORMATION

Blank lined area for additional information.

B.W.V.