

CODED

MISSISSIPPI
BOARD OF WATER COMMISSIONERS
416 North State Street
Jackson, Mississippi 39201

WATER WELL DRILLERS LOG

Smith
Q 15
6-14-69

6-14 date well completed 1969 W.K. Barnes Water Wells firm name Smith county well located

LANDOWNER: Vernie Robinson

description of formations encountered

from to

Rt. 1

Red Clay

0 10

Saylorville miss.
(mailing address)

yellow clay

10 30

Fine Sand

30 45

yellow Clay

65 67

Waty sand

67 74

WELL LOCATION:

sec. 7 T 10 N R 15 E
S W
1 miles So of Mize
(distance) (direction) (nearest town)

WELL PURPOSE: Home
(home, irrigation, municipal, industrial)

WELL COMPLETION DATA:

- (1) diameter (inches) 2
- (2) total depth (feet) 74
- (3) static water level (feet) 35 below top of ground.
- (4) casing Galv. (material), (depth),
2" if telescope see back.
(size)
- (5) screen 4 (length), (depth to top)
8 Slot, Stainless Steel
(size) (material)
- (6) pump 1/2 (HP), 6 (yield gpm)
Elec. (type power)
- (7) electric log no (yes or no)
- (organization running log)
- (8) how well bottom plugged Wash valve


DRILLERS REMARKS:

JUN 30 1969

MISS. BD. OF
WATER COM.

If well telescopes please sketch and show depths.

GROUND LEVEL

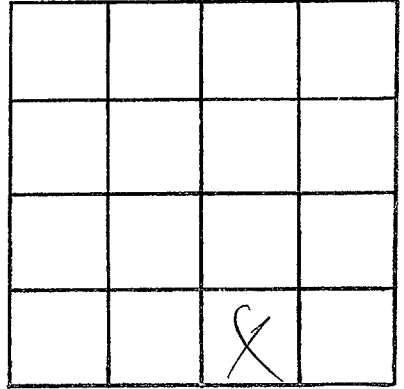

SECTION 7

Please indicate well location X.

ADDITIONAL INFORMATION

If more than one screen, show locations of each on sketch.