

SMITH
Q22
12-11-70

MISSISSIPPI
BOARD OF WATER COMMISSIONERS
416 North State Street
Jackson, Mississippi 39201

CODED

FEB 17 1971

MISS. BD. OF
WATER COMM.

WATER WELL DRILLERS LOG

12-11 date well completed 1970 P.W.K. Barnes Water Wells firm name Smith county well located

LANDOWNER: J. E. Corley
Rte 1 Taylorsville
Miss.
(mailing address)

description of formations encountered	from	to
Red Clay	0	12
Red sand	12	30
yellow clay	30	46
fine sand	46	94
Course sand	94	151

WELL LOCATION:
sec. 25 T. 10 N. R. 15 E.
S W

_____ miles _____ of _____
(distance) (direction) (nearest town)

WELL PURPOSE: Home use
(home, irrigation, municipal, industrial)

WELL COMPLETION DATA:

(1) diameter (inches) 2

(2) total depth (feet) 151

(3) static water level (feet) 89 below above top of ground.

(4) casing Galv. 147 (material) (depth)

2" (size) if telescope see back.

(5) screen 4' (length) (depth to top)

08 (size) Stainless Steel (material)

(6) pump 1 1/2 (HP) 7 (yield gpm)

Elec. (type power)

(7) electric log 410 (yes or no)

(organization running log)


(8) how well bottom plugged Wash valve

CODED

DRILLERS REMARKS:

If well telescopes please sketch and show depths.

GROUND LEVEL

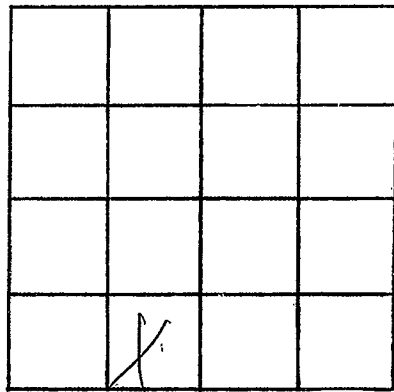

SECTION 25

Please indicate well location X.

ADDITIONAL INFORMATION

If more than one screen,
show locations of each on sketch.