

SMITH
Q 23
5-20-71

MISSISSIPPI
BOARD OF WATER COMMISSIONERS
416 North State Street
Jackson, Mississippi 39201

CODED

WATER WELL DRILLERS LOG

5/20 1971 date well completed
J.R. Polze Water Well Drilling firm name
Smith county well located

LANDOWNER: Taylor Sullivan
RT 1 Meza
(mailing address)

| description of formations encountered | from | to |
|---------------------------------------|------|----|
| chalk | 0 | 30 |
| concrete band | 30 | 60 |

WELL LOCATION:
sec. 21 T-10N R-15E S
10 miles East of Taylor, Miss.
(distance) (direction) (nearest town)

WELL PURPOSE: HOME
(home, irrigation, municipal, industrial)

- WELL COMPLETION DATA:
- (1) diameter (inches) 2"
 - (2) total depth (feet) 60 ft
 - (3) static water level (feet) 20 ^{below} / _{above} top of ground.
 - (4) casing galv. 56 ft.
(material) (depth)
 - (size) if telescope see back.
 - (5) screen 4 ft. ~~60 ft.~~
(length) (depth to top)
 - 1 1/4" 33
(size) (material)
 - (6) pump 3/4 HP 8
(HP) (yield gpm)
 - jet
(type power)
 - (7) electric log (yes or no)
 - (organization running log)
 - (8) how well bottom plugged Chalk

CODED


MAY 24 1971

MISS. BD. OF
WATER COMM.

DRILLERS REMARKS:

If well telescopes please sketch and show depths.

GROUND LEVEL

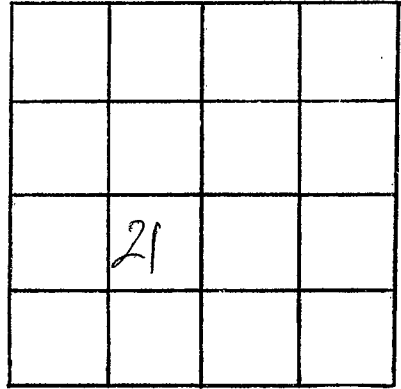

SECTION 21

Please indicate well location X.

ADDITIONAL INFORMATION

*Go West off Taylorville
Cross upper cobble
Bridge first houses
on left*

If more than one screen,
show locations of each on sketch.