

SMITH

Q 24

6-26-71

MISSISSIPPI BOARD OF WATER COMMISSIONERS 416 North State Street Jackson, Mississippi 39201

CODED

WATER WELL DRILLERS LOG

6-26

1971 W.R. Barnes Water wells

Smith

date well completed

firm name

county well located

LANDOWNER: V.R. King

Jaylorsville miss.

(mailing address)

WELL LOCATION:

sec. 12 T 10 N S R 15 E W

(distance) miles (direction) of (nearest town)

WELL PURPOSE: Water
(home, irrigation, municipal, industrial)

WELL COMPLETION DATA:

- (1) diameter (inches) 2
- (2) total depth (feet) 136
- (3) static water level (feet) 39 below above top of ground.

(4) casing Galv.
(material) (depth)

2"
(size) If telescope see back.

(5) screen 4 ft.
(length) (depth to top)

08, Stainless Steel
(size) (material)

(6) pump 3/4 15
(HP) (yield gpm)

Elec.
(type power)

(7) electric log no
(yes or no)

(organization running log)

(8) how well bottom plugged wash down

DRILLERS REMARKS:

description of formations encountered

from

to

| | | |
|-------------|-----|-----|
| Red Clay | 0 | 8 |
| yellow clay | 8 | 34 |
| Fine Sand | 34 | 36 |
| yellow clay | 36 | 60 |
| Rock | 60 | 61 |
| yellow clay | 61 | 92 |
| Fine Sand | 92 | 121 |
| Course Sand | 121 | 136 |


CODED

JUL 23 1971

MISS. BD. OF WATER COMM.

If well telescopes please sketch and show depths.

GROUND LEVEL

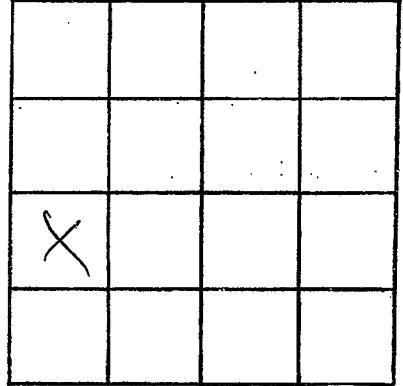

SECTION 12

Please indicate well location X.

ADDITIONAL INFORMATION

If more than one screen,
show locations of each on sketch.