

SMITH

Q25

7-27-71

7-27-71

MISSISSIPPI BOARD OF WATER COMMISSIONERS 416 North State Street Jackson, Mississippi 39201

CODED

WATER WELL DRILLERS LOG

1971 W.K. Barnes Water Wells Smith

date well completed

firm name

county well located

LANDOWNER: Hopewell Church
Route 2
Taylorsville Miss.
(mailing address)

description of formations encountered

from

to

Red Clay	0	10
yellow clay	10	22
fine sand	22	28
yellow clay	28	25
course sand	25	28
yellow clay	28	78
course sand	78	130
	130	151

WELL LOCATION:

sec. 30 T. 10 N. R. 15 E. S. 1
7 miles SOUTH of TAYLORSVILLE
(distance) (direction) (nearest town)

WELL PURPOSE: Church
(home, irrigation, municipal, industrial)

WELL COMPLETION DATA:

- (1) diameter (inches) 2
- (2) total depth (feet) 151
- (3) static water level (feet) 54 below above top of ground.
- (4) casing Galv. (material) (depth)
02" (size) if telescope see back.
- (5) screen 4 ft. (length) (depth to top)
07 (size) Stainless Steel (material)
- (6) pump 3/4 (HP) 8 (yield gpm)
Elec. (type power)
- (7) electric log no (yes or no)
- (organization running log)
- (8) how well bottom plugged Wash Valve

CODED


JUL 29 1971

MISS. BD. OF WATER COMM.

DRILLERS REMARKS:

If well telescopes please sketch and show depths.

GROUND LEVEL

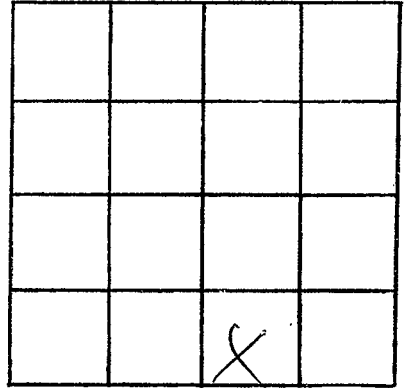

SECTION 30

Please indicate well location X.

ADDITIONAL INFORMATION

If more than one screen,
show locations of each on sketch.