

SMITH
Q28
3-22-72

MISSISSIPPI
 BOARD OF WATER COMMISSIONERS
 416 North State Street
 Jackson, Mississippi 39201

CODED

WATER WELL DRILLERS LOG

3-22 1972 W.K. Barnes Water Well Smith
 date well completed firm name county well located

LANDOWNER: Billy Hanes
Route one
Jaylorsville Miss.
 (mailing address)

description of formations encountered	from	to
Red Clay	0	18
yellow clay	18	28
Blue Clay	28	75
Fine Sand	75	92
Blue Clay	92	116
Rock	116	121
White Clay	121	130
Fine Sand	130	151

WELL LOCATION:
 sec. 36 T. 10 N. R. 15 E.
4 miles S.E. of Jaylorsville
 (distance) (direction) (nearest town)

WELL PURPOSE: Home
 (home, irrigation, municipal, industrial)

WELL COMPLETION DATA:

(1) diameter (inches) 2

(2) total depth (feet) 151

(3) static water level (feet) 77 below above top of ground.

(4) casing Galv. (material) (depth) 2" (size) if telescope see back.

(5) screen 4' (length) (depth to top) 0.6 (size) Stainless Steel (material)

(6) pump 3/4 (HP) 8 (yield gpm)
Elec. (type power)

(7) electric log (yes or no) _____
 (organization running log) _____

(8) how well bottom plugged Washed

CODED


AUG 15 1972

MISS. PD. G.
 WATER BOARD

DRILLERS REMARKS:

If well telescopes please sketch and show depths.

GROUND LEVEL

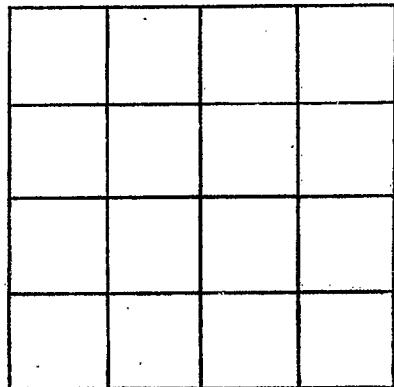

SECTION _____

Please indicate well location X.

ADDITIONAL INFORMATION

If more than one screen,
show locations of each on sketch.