

SMITH

MISSISSIPPI BOARD OF WATER COMMISSIONERS  
416 North State Street  
Jackson, Mississippi 39201

COUNTINGTON  
Q 30  
8-29-72

WATER WELL DRILLERS LOG

CODED SMITH

8-29 date well completed      W.K. James Water wells firm name      county well located

LANDOWNER: <u>D.W. Hayes</u>	description of formations encountered	from	to
<u>Plot. 1 cont. olive</u>			
	<u>Red Sand</u>	<u>12</u>	<u>38</u>
(mailing address)	<u>Course White Sand</u>	<u>38</u>	<u>77</u>

WELL LOCATION: sec. 8 T. 15 S. R. 13 E. W  
3 miles W of Hattiesburg  
(distance) (direction) (nearest town)

WELL PURPOSE: HOME  
(home, irrigation, municipal, industrial)

- WELL COMPLETION DATA:
- (1) diameter (inches) 2
  - (2) total depth (feet) 72
  - (3) static water level (feet) 52 below above top of ground.
  - (4) casing Galv. (material), (depth)
  - 2" (size) If telescope see back.
  - (5) screen 4 (length), (depth to top)
  - 08 (size), Stainless Steel (material)
  - (6) pump 3/4 (HP), 8 (yield gpm)
  - Elec. (type power)
  - (7) electric log (yes or no)
  - (organization running log)
  - (8) how well bottom plugged wash valve


CODED

DRILLERS REMARKS:

MISS. BD. OF WATER COMMISSIONERS

If well telescopes please sketch and show depths.

GROUND LEVEL

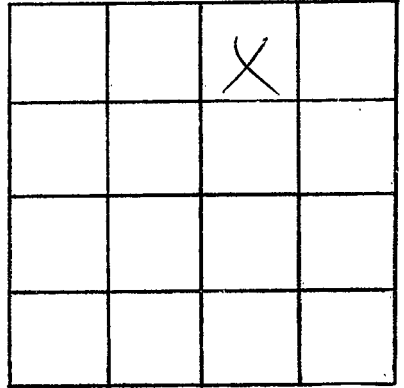

SECTION 8

Please indicate well location X.

ADDITIONAL INFORMATION

If more than one screen,  
show locations of each on sketch.