

SMITH
Q31
11-4-72

MISSISSIPPI
BOARD OF WATER COMMISSIONERS
416 North State Street
Jackson, Mississippi 39201

CODED

WATER WELL DRILLERS LOG

11/4 1972 J.R. Parker Waterwell Smith
date well completed firm name county well located

LANDOWNER: J.C. Robinson
Taylorville Miss
Rt 1
(mailing address)

description of formations encountered	from	to
Chalk	0	10
Corde sand	10	25
Rock	25	26
Chalk	26	40
water sand	40	60

WELL LOCATION:
sec. 26 T. 10 N R. 15 E
S W
1 1/2 miles west of Taylorville
(distance) (direction) (nearest town)

WELL PURPOSE: Home
(home, irrigation, municipal, industrial)

- WELL COMPLETION DATA:
- diameter (inches) 2 1/2
 - total depth (feet) 60
 - static water level (feet) 50 ^{below} above top of ground.
 - casing PVC, 55 (material) (depth)
(size) if telescope see back.
 - screen 5 (length) 60 (depth to top)
1 1/2" (size) 5/5 (material)
 - pump Jet (HP) 7 (yield gpm)
elec (type power)
 - electric log (yes or no)
 - (organization running log)
 - how well bottom plugged chalk

CODED


DEC 14 1972

DRILLERS REMARKS:

MISS. Bd. WATER SURVEY

If well telescopes please sketch and show depths.

GROUND LEVEL

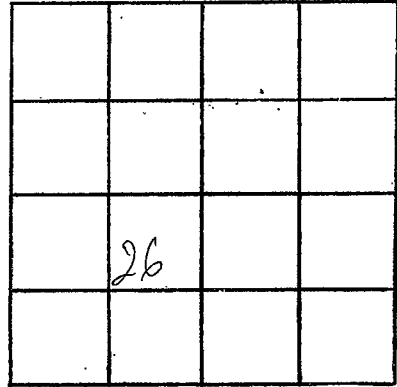

R15W

SECTION 26

Please indicate well location X.

ADDITIONAL INFORMATION

Taylorville go to
fillow Sh. church
keep left of house on
left of ~~the~~

J. C. Robinson

If more than one screen,
show locations of each on sketch.