

**MISSISSIPPI
BOARD OF WATER COMMISSIONERS**
416 North State Street
Jackson, Mississippi 39201

WATER WELL DRILLERS LOG

SMITH
Q32
12-7-73

12/7 19**73**
date well completed

J.R. Parkes Water Well
firm name

Smith
county well located

LANDOWNER: *Bill Hornum*

description of formations encountered

from to

Taylorville, Miss

*Red sand
clay
sand*

*0 20
20 90
90 115*

Bot
(mailing address)

WELL LOCATION:

sec. *8* T *10* N R *15* E
1/4 miles *W* of *T. VILLE*
(distance) (direction) (nearest town)

WELL PURPOSE: *HOME*
(home, irrigation, municipal, industrial)

WELL COMPLETION DATA:

CODED

(1) diameter (inches) *2*
(2) total depth (feet) *115*
(3) static water level (feet) *60* below above
top of ground.

(4) casing *PVC* *110*
(material) (depth)

(size) if telescope see back.

(5) screen *5'* *115*
(length) (depth to top)
2" *PVC*
(size) (material)

(6) pump *1HP* *7*
(HP) (yield gpm)
Jet
(type power)

(7) electric log (yes or no)

(organization running log)


(8) how well bottom plugged *chalk*

DRILLERS REMARKS:

MISS. DEP. OF
WATER

If well telescopes please sketch and show depths.

GROUND LEVEL

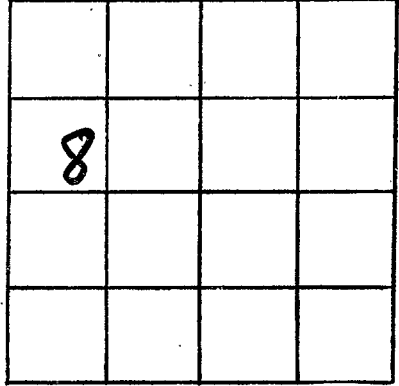

R15W

SECTION 8

Please indicate well location X.

ADDITIONAL INFORMATION

*go to Taylorville
to well 5 or 12
est.*

If more than one screen,
show locations of each on sketch.