


Smith
Q 33
5-30-75

MISSISSIPPI
BOARD OF WATER COMMISSIONERS
416 North State Street
Jackson, Mississippi 39201

WATER WELL DRILLERS LOG CODED

date well completed May 30 1975 SR. GREEN - WATER WELL DRILLING Smith
RTE. 6, BOX 5A PHONE 425-3237 county well located
LAUREL, MISS. 39440


LANDOWNER: <u>Hershel Hodge</u>	description of formations encountered	from	to
<u>Route 3 Taylorsville</u>	<u>white chalk</u>	<u>0</u>	<u>10</u>
<u>39168</u>	<u>" "</u>	<u>10</u>	<u>12</u>
(mailing address)	<u>yellow "</u>	<u>12</u>	<u>16</u>
WELL LOCATION:	<u>pea gravel</u>	<u>16</u>	<u>18</u>
sec <u>27 T. 10N</u> R. <u>15 E</u>	<u>white chalk</u>	<u>18</u>	<u>20</u>
<u>3</u> miles <u>SW</u> of <u>Taylorsville</u>	<u>" "</u>	<u>20</u>	<u>26</u>
(distance) (direction) (nearest town)	<u>coarse sand</u>	<u>26</u>	<u>28</u>
WELL PURPOSE:	<u>fine "</u>	<u>28</u>	<u>30</u>
<u>(home) Irrigation, municipal, industrial</u>	<u>" "</u>	<u>30</u>	<u>40</u>
WELL COMPLETION DATA:	<u>" "</u>	<u>40</u>	<u>48</u>
(1) diameter (inches) <u>11"</u>	<u>pea gravel</u>	<u>48</u>	<u>50</u>
(2) total depth (feet) <u>200</u>	<u>blue chalk CODED</u>	<u>50</u>	<u>60</u>
(3) static water level (feet) <u>15</u> below top of ground.	<u>" "</u>	<u>60</u>	<u>70</u>
(4) casing <u>PVC</u> (material) <u>115</u> (depth)	<u>" "</u>	<u>70</u>	<u>80</u>
(size) If telescope see back.	<u>" "</u>	<u>80</u>	<u>90</u>
(5) screen <u>5'</u> (length) <u>45</u> (depth to top)	<u>fine sand</u>	<u>90</u>	<u>100</u>
<u>2 1/2" O.D.</u> (size) <u>PVC</u> (material)	<u>" "</u>	<u>100</u>	<u>110</u>
(6) pump <u>1/2</u> (HP) <u>5</u> (yield gpm)	<u>fine sand</u>	<u>110</u>	<u>118</u>
<u>110VAC</u> (type power)	<u>medium "</u>	<u>118</u>	<u>120</u>
(7) electric log <u>N</u> (yes or no)	<u>" "</u>	<u>120</u>	<u>124</u>
(organization running log)	<u>chalk</u>	<u>124</u>	<u>130</u>
(8) how well bottom plugged	<u>fine sand</u>	<u>130</u>	<u>132</u>
DRILLERS REMARKS:	<u>" "</u>	<u>132</u>	<u>136</u>
	<u>hard</u>	<u>136</u>	<u>140</u>
	<u>live sand</u>	<u>140</u>	<u>143</u>
	<u>" "</u>	<u>143</u>	<u>150</u>
	<u>" "</u>	<u>150</u>	<u>160</u>
	<u>" "</u>	<u>160</u>	<u>170</u>
	<u>" "</u>	<u>170</u>	<u>180</u>
	<u>" "</u>	<u>180</u>	<u>188</u>
	<u>" "</u>	<u>188</u>	<u>190</u>
	<u>" "</u>	<u>190</u>	<u>200</u>

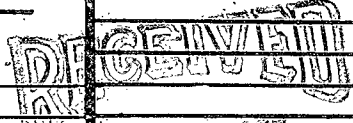

MISSISSIPPI BOARD OF WATER COMM

If well telescopes please sketch and show depths.

GROUND LEVEL

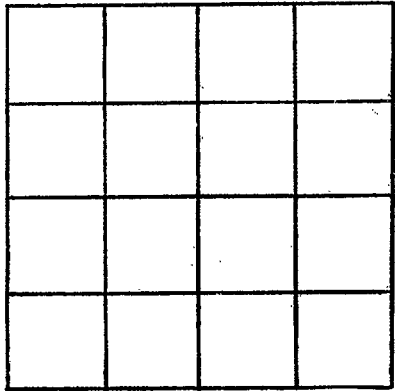

SECTION 27

Please indicate well location X.

ADDITIONAL INFORMATION

If more than one screen, show locations of each on sketch.